

KANSAS

Marion

FORM 51.5M PETROL

Section 3 Township 17 Range 4-EWell No. #4-McNickel

(McNickel)

Company Bob Youker

		0							

NORTH

WEST

EAST

SOUTH

6

✓


KANSAS

FORM 252-A
SM 9-43 GASS

Marion

Sec. 3 Twp. 17 R. 4-EWell No. #4 McNickol FarmBob Youker Company

NORTH

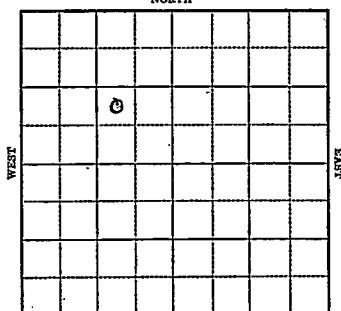 Ft. from N. Line990 Ft. from S. Line990 Ft. from E. Line Ft. from W. LineElev. 1414

1943

R E P O R T

10/27 Machine

11/3 "

11/10 15" @ 105

Drlg. 625'

11/17 12" @ 804'

Drlg. 1350'

11/24 10" @ 1430'

8" @ 1800'

Drlg 1820'

12/1 Drlg. 2150'

12/8 Miss 2297

TD 2336

HFO

5" @ 2308

12/15 5" @ 2308

Chat 2297

Pump 300 Pot

TD 2352

Gravity 36

COMPLETED

KANSAS 26
 Map No. 26 Sec. 3 Twp. 17 R. 4E

Well No. 4 McNickol

Bob Youker

Company

FIRST REPORT

Contractor

NW SE NW


SECTION PLAT

_____ Ft. from N. Line

990 Ft. from S. Line

990 Ft. from E. Line

_____ Ft. from W. Line

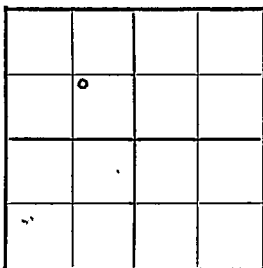

Lost Spring Pool

Location _____

Rig up _____

Drilling and Remarks:

Machine

RECORD

Cased _____ in., _____ ft.

Sand _____

Gas _____

Oil _____

Total Depth _____

PRODUCTION

1st 24 hrs. Nat. _____

1st 24 hrs. after shot _____

Gas _____ Cu. Ft.

Dry Hole _____

Abandoned _____

Date

OCT 27 1943 19

S. J. LEWIS Scout

KANSAS

Map No. 26 Sec. 3 Twp. 17 R. 4EWell No. 4 MonickolBob Youker CompanyCOMPLETED Contractor

NW SE NW

SECTION PLAT

 Ft. from N. Line990 Ft. from S. Line990 Ft. from E. Line Ft. from W. Line

	0		

Lost Spring PoolLocation Rig up

Drilling and Remarks:

Chas 22975" @ 2308Pump 800 Bbl26 0 Gr

RECORD

Cased in., ft.Sand Gas Oil Total Depth 2352

PRODUCTION

1st 24 hrs. Nat. 1st 24 hrs. after shot Gas Cu. Ft.Dry Hole Abandoned

Date

DEC 15 1943 19 S. J. LEWIS Scout