


Section 3 Township 17 Range 4E

Well No. 4 McNichol "A" (*McNichol*)

Company R. E. Youker & Enger

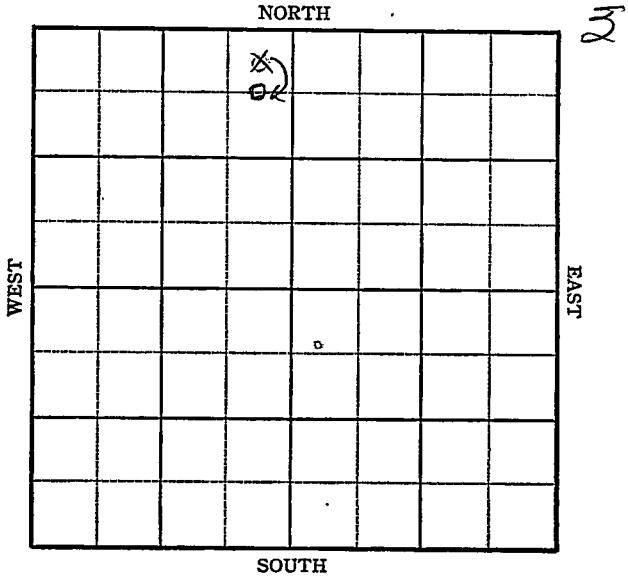

Sec. 3 Twp. 17 R. 4-E

Well No. #4 McNichol "A" Farm


R. E. Youker & Enger Company

660
~~330~~ Ft. from N. Line

_____ Ft. from S. Line

330 Ft. from E. Line

_____ Ft. from W. Line

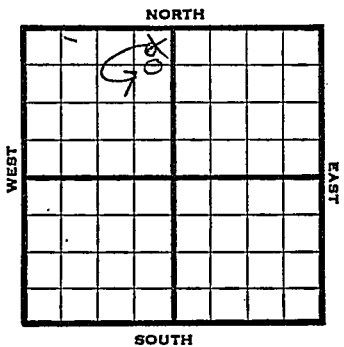

~~NE NW~~ CE L NE NW

1945 Elev. 1386 REPORT

11/21 Cable

11/28 Rig

12/5 Spud

12/12 13" @ 120
Drlg. 605

12/20 10" - 998' Drlg. 1468'

12/29 SD 1570'

1946

1/10 Miss. 2260' T.D. 2265' SO.
5" - 2265'

1/16 Chat 2264
5" @ 2269
TD 2329
Pump 60 oil plus 100 W. Pot.
Grav. 36.7

COMPLETED

KANSAS

Kansas Pool Name Lost SpringMap No. 26 Sec. 3 Twp. 17 R. 4EWell No. 4 McNichol "A"R. E. Youker & Enger Company

FIRST REPORT

Contractor

NE NW

SECTION PLAT

		o	

330 Ft. from N. Line

Ft. from S. Line

330 Ft. from E. Line

Ft. from W. Line

Marion County

Location

Rig up

Drilling and Remarks:

Cable

RECORD

Cased _____ in., _____ ft.

Sand _____

Gas _____

Oil _____

Total Depth _____

PRODUCTION

1st 24 hrs. Nat. _____

1st 24 hrs. after shot _____

Gas _____ Cu. Ft.

Dry Hole _____

Abandoned _____

Date

NOV 21 1945

19

S. J. LEWIS

Scout

KANSAS

Kansas Pool Name Lost SpringMap No. K-26 Sec. 3 Twp. 17 R. 4EWell No. 4 McNichol "A"R. E. Youker & Enger Company**CORRECTION**

Contractor

C E L NE NW

SECTION PLAT

660 Ft. from N. Line Ft. from S. Line330 Ft. from E. Line Ft. from W. Line

	o		

Marion County

Location _____

Rig up _____

Drilling and Remarks:

reported

NE NW

RECORD

Cased _____ in., _____ ft.

Sand _____

Gas _____

Oil _____

Total Depth _____

PRODUCTION

1st 24 hrs. Nat. _____

1st 24 hrs. after shot _____

Gas _____ Cu. Ft.

Dry Hole _____

Abandoned _____

Date

DEC 1 9 1945 19

S. J. LEWIS Scout

Kansas Pool Name Lost Spring pool

KANSAS
Map No. 26 Sec. 3 Twp. 17 R. 4E

Well No. 4 McNichol "A"

R. E. Youker and Enger Company

COMPLETED

Contractor

C EL NE NW

E. B. B.

SECTION PLAT

660 Ft. from N. Line

 Ft. from S. Line

330 Ft. from E. Line

 Ft. from W. Line

		0	

Marion County

Location _____

Rig up _____

Drilling and Remarks:

Chas 2264
5' @ 2269
Run 60 oil +
100W P.D.

36 2/3

RECORD

Cased _____ in., _____ ft.

Sand _____

Gas _____

Oil _____

Total Depth 2229

PRODUCTION

1st 24 hrs. Nat. _____

1st 24 hrs. after shot _____

Gas _____ Cu. Ft.

Dry Hole _____

Abandoned _____

Date

IAN 1 6 1946 19

S. J. LEWIS Scout