

# KANSAS


Marion

FORM 51 SM 1-42 PETROL

Section 3 Township 17 Range 4-E

Well No. #3-McNickol *(McNicol)*

Company Bob Youker

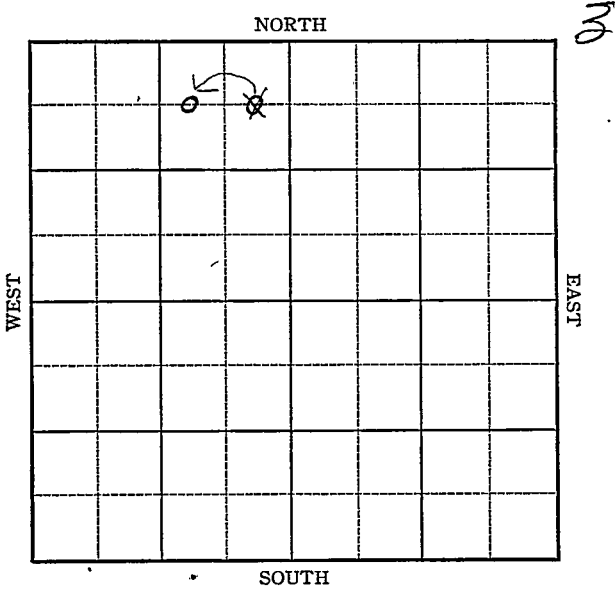

Sec. 3 " Twp. 17 R. 4-E

Well No. #3 McNickol Farm

Bob Youker Company


Lost Spring

660 Ft. from N. Line

\_\_\_\_\_ Ft. from S. Line

990  
~~330~~ Ft. from E. Line

\_\_\_\_\_ Ft. from W. Line

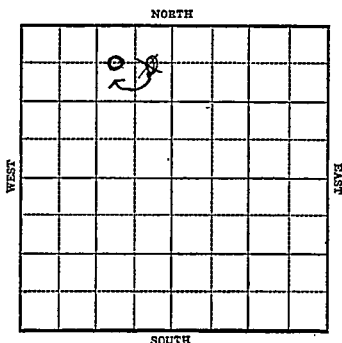

1943

R E P O R T

7/7	Machine
7/15	15" @ 96' Drlg. 500'
7/21	12" @ 1010 Drlg. 1018'
7/28	10" @ 1420' 8" @ 1707 Drlg. 1730' Drlg. 2080'
8/4	
8/11	6" @ 2170 Chat 2302 SO 2306 Drlg. 2316'
8/18	Chat 2302 6" @ 2304 Pump 150 Pot. T.D. 2447 Grav 36

COMPLETED

Map No. KANSAS 2A6 Sec. 3 Twp. 17 R. 4E

Well No. 3 McNickol

Bob Youker Company

FIRST REPORT Contractor

C WL NE NW

660 Ft. from N. Line

\_\_\_\_\_ Ft. from S. Line

330 Ft. from E. Line

\_\_\_\_\_ Ft. from W. Line

SECTION PLAT


LOST SPRING POOL

Location \_\_\_\_\_

Rig up \_\_\_\_\_

Drilling and Remarks:

**Machine**

RECORD

Cased \_\_\_\_\_ in., \_\_\_\_\_ ft.

Sand \_\_\_\_\_

Gas \_\_\_\_\_

Oil \_\_\_\_\_

Total Depth \_\_\_\_\_

PRODUCTION

1st 24 hrs. Nat. \_\_\_\_\_

1st 24 hrs. after shot \_\_\_\_\_

Gas \_\_\_\_\_ Cu. Ft.

Dry Hole \_\_\_\_\_

Abandoned \_\_\_\_\_

Date

JUL 7 1943 19

S I LEWIS Scout

**KANSAS**

**Marion**

Map No. 26 Sec. 3 Twp. 17 R. 4E

Well No. 3 McNichol

Bob Youker Company

CORRECTION Contractor

**C WL NE NW**

660 Ft. from N. Line

         Ft. from S. Line

990 Ft. from E. Line

         Ft. from W. Line

**SECTION PLAT**

	o		

**LOST SPRING POOL**

Location \_\_\_\_\_

Rig up \_\_\_\_\_

Drilling and Remarks:

**Had spotted**

**C EL NE NW**

**RECORD**

Cased \_\_\_\_\_ in., \_\_\_\_\_ ft.

Sand \_\_\_\_\_

Gas \_\_\_\_\_

Oil \_\_\_\_\_

Total Depth \_\_\_\_\_

**PRODUCTION**

1st 24 hrs. Nat. \_\_\_\_\_

1st 24 hrs. after shot \_\_\_\_\_

Gas \_\_\_\_\_ Cu. Ft.

Dry Hole \_\_\_\_\_

Abandoned \_\_\_\_\_

Date

JUL 14 1943 19

S. J. LEWIS Scout

Marion:

KANSAS

Map No. 26 Sec. 3 Twp. 17 R. 4EWell No. 3 McNicholBob Youker CompanyCOMPLETED Contractor

## SECTION PLAT

660 C W L NE NW  
Ft. from N. Line

Ft. from S. Line

990 Ft. from E. Line

Ft. from W. Line

LOST SPRING POOL

	0		

Location \_\_\_\_\_

Rig up \_\_\_\_\_

Drilling and Remarks:

*Oka 2302**6" @ 2304**Pump 1500 ft**36 2/3*

## RECORD

Cased \_\_\_\_\_ in., \_\_\_\_\_ ft.

Sand \_\_\_\_\_

Gas \_\_\_\_\_

Oil \_\_\_\_\_

Total Depth 2447

## PRODUCTION

1st 24 hrs. Nat. \_\_\_\_\_

1st 24 hrs. after shot \_\_\_\_\_

Gas \_\_\_\_\_ Cu. Ft.

Dry Hole \_\_\_\_\_

Abandoned \_\_\_\_\_

Date

AUG 18 1943

19

S. J. LEWIS Scout