


Map No. **KANSAS** Sec. 3 Twp. 17 R. 4  
Well No. 1-Martin Farm  
Acker + Hoffman Company  
NORTH

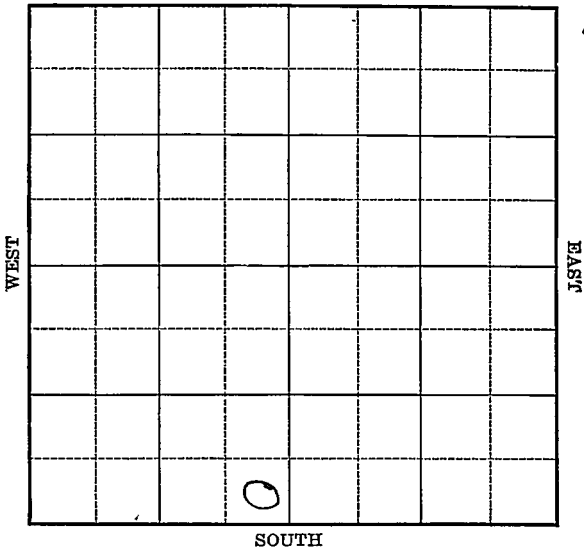

Location \_\_\_\_\_

Drilling Remarks \_\_\_\_\_

\_\_\_\_\_  
\_\_\_\_\_  
Rig Up \_\_\_\_\_

Drilling Remarks \_\_\_\_\_

\_\_\_\_\_  
\_\_\_\_\_  
**RECORD**

Cased \_\_\_\_\_ in. \_\_\_\_\_ ft.  
Sand \_\_\_\_\_  
Gas \_\_\_\_\_  
Oil \_\_\_\_\_  
Total Depth \_\_\_\_\_

**PRODUCTION**

1st 24 hrs. Nat. \_\_\_\_\_  
1st 24 hrs. after shot \_\_\_\_\_  
Gas \_\_\_\_\_ cu. ft.  
Dry Hole \_\_\_\_\_  
Abandoned \_\_\_\_\_

Map No. \_\_\_\_\_ Sec. 3 Twp. 17 R 4 E


Well No. 1-Martin Farm  
Ucker & Hoffmann Company

\_\_\_\_\_ Ft. from N. Line

330 Ft. from S. Line

330 Ft. from E. Line

\_\_\_\_\_ Ft. from W. Line

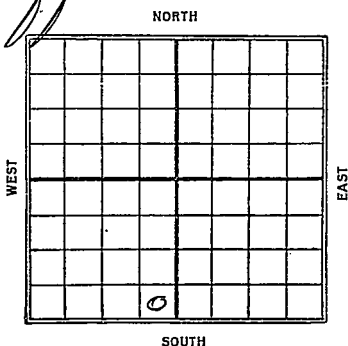

1928

Date REPORT

Date	REPORT
5/3	R.O.G.
5/10	Rig
5/18	Rigging up
5/24	Spudding
5/31	wrlg. 450
6/7	" 810
6/14	" 1700
6/21	S.D. 1780
6/28	Drilg 2115
7/6	Top Chat 2350 - drilg -
7/13	S/D 2350
7/19	Chat 2345-93 small show shut down -
7/25	2345-2393 T.O. 2393 50 bbls



*Mallon*

MAP NO. KANSAS SEC. 3 TWP. 17 R. 4

WELL NO. 1 *Mallon*

*Mcker & Hoggan* COMPANY

CONTRACTOR

COMPLETED

SECTION PLAT

\_\_\_\_\_ FT. FROM N. LINE  
330 FT. FROM S. LINE  
330 FT. FROM E. LINE  
 \_\_\_\_\_ FT. FROM W. LINE


LOCATION \_\_\_\_\_

RIG UP \_\_\_\_\_

DRILLING AND REMARKS:

*50 Pfo.*

RECORD

CASED \_\_\_\_\_ IN. \_\_\_\_\_ FT.  
 SAND 2345-2393  
 GAS \_\_\_\_\_  
 OIL \_\_\_\_\_  
 TOTAL DEPTH 2393

PRODUCTION

1ST 24 HRS. NAT. \_\_\_\_\_  
 1ST 24 HRS. AFTER SHOT \_\_\_\_\_  
 GAS \_\_\_\_\_ CU. FT.  
 DRY HOLE \_\_\_\_\_  
 ABANDONED \_\_\_\_\_

DATE JUL 25 1928

CHAS. L. SHERWOOD