


KANSAS Morris

FORM 51 5M PETROL

Section 30 Township 17 Range 5E

Well No. 3 Nelson

Company A. Loriaux etal

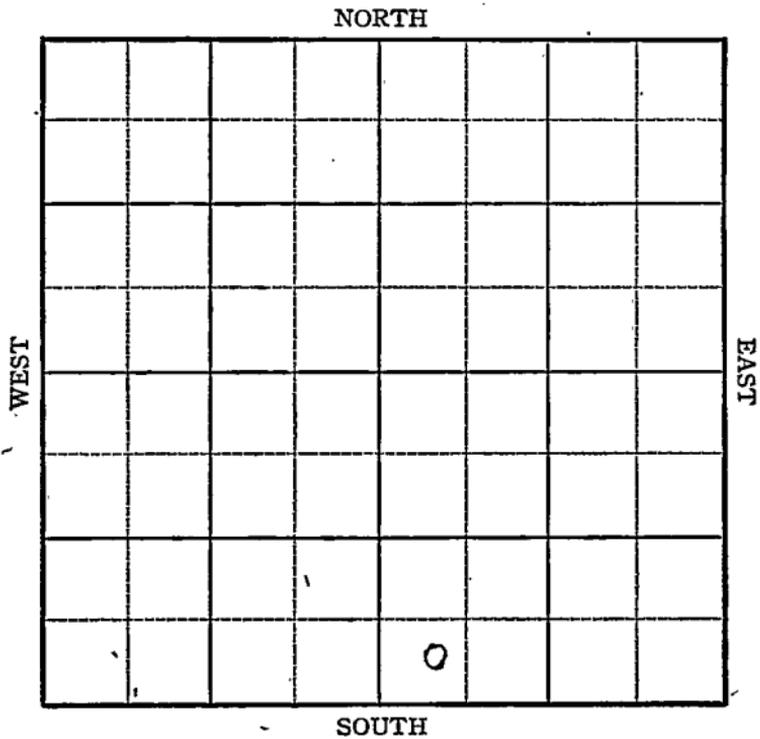

KANSAS Morris

Sec. 30 Twp. 17 R. 5-E


Well No. #3 Nelson Farm  
A. Loriaux etal Company

400 Ft. from N. Line

~~330~~ Ft. from S. Line

~~330~~ Ft. from E. Line

400 Ft. from W. Line

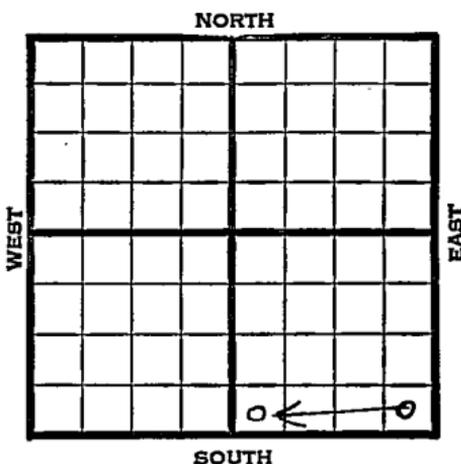

~~SE/c~~ SW SE

1945 Elev. 1482 REPORT

7/18 Machine  
7/26 M "

8/1 Drlg. 115  
8/8 Drlg. 840  
12" @ 189  
8/15 10" @ 1005  
Drlg. 1355  
8/22 8" @ 1428  
Lans 1770  
Drlg. 1810  
8/29 6" @ 1910  
1950 UR 6"  
9/5 5" @ 1960  
Drlg. 2285  
9/12 Miss. 2288  
5" @ 2288'  
TD 2306  
1500' oil 10 hrs.  
9/19 Chat 2288.  
5" @ 2288'  
TD 2306'  
Pump 100 Pot.  
Grav. 36.0

COMPLETED

**KANSAS** Kansas Pool Name Lost Spring

Map No. 26 Sec. 30 Twp. 17 R. 5E

Well No. 3 Nelson

A. Loriaux etal Company

**FIRST REPORT**

Contractor

SE/c

**SECTION PLAT**

\_\_\_\_\_ Ft. from N. Line

330 Ft. from S. Line

330 Ft. from E. Line

\_\_\_\_\_ Ft. from W. Line

			0

Morris County

Location \_\_\_\_\_

Rig up \_\_\_\_\_

Drilling and Remarks:

machine

**RECORD**

Cased \_\_\_\_\_ in., \_\_\_\_\_ ft.

Sand \_\_\_\_\_

Gas \_\_\_\_\_

Oil \_\_\_\_\_

Total Depth \_\_\_\_\_

**PRODUCTION**

1st 24 hrs. Nat. \_\_\_\_\_

1st 24 hrs. after shot \_\_\_\_\_

Gas \_\_\_\_\_ Cu. Ft.

Dry Hole \_\_\_\_\_

Abandoned \_\_\_\_\_

Date

JUL 1 8 1945 19

S. J. LEWIS Scout

KANSAS

Kansas Pool Name Lost SpringMap No. 26 Sec. 30 Twp. 17 R. 5EWell No. 3 NelsonA. Loriaux etal

Company

**CORRECTION**

Contractor

SW SE

## SECTION PLAT

         Ft. from N. Line400 Ft. from S. Line         Ft. from E. Line400 Ft. from W. Line


Morris County

Location                                 Rig up                                 Drilling and Remarks:  
reported SE/c

## RECORD

Cased                  in.,                  ft.Sand                                 Gas                                 Oil                                 Total Depth                                 

## PRODUCTION

1st 24 hrs. Nat.                                 1st 24 hrs. after shot                                 Gas                                  Cu. Ft.Dry Hole                                 Abandoned                                 

Date

JUL 25 1945 19S. J. LEWIS Scout

Pool Name Lost Spring

KANSAS Kansas

Map No. 26 Sec. 30 Twp. 17 R. 5EWell No. 3 NelsonA. Loriaux etal Company**COMPLETED**

Contractor

E. 11482

SW SE

SECTION PLAT

         Ft. from N. Line400 Ft. from S. Line         Ft. from E. Line400 Ft. from W. Line


Morris County

Location \_\_\_\_\_

Rig up \_\_\_\_\_

Drilling and Remarks:

Opa 22885" @ 2288Pump 100 PD36 2/3**RECORD**

Cased \_\_\_\_\_ in., \_\_\_\_\_ ft.

Sand \_\_\_\_\_

Gas \_\_\_\_\_

Oil \_\_\_\_\_

Total Depth 2306**PRODUCTION**

1st 24 hrs. Nat. \_\_\_\_\_

1st 24 hrs. after shot \_\_\_\_\_

Gas \_\_\_\_\_ Cu. Ft.

Dry Hole \_\_\_\_\_

Abandoned \_\_\_\_\_

Date

SEP 1 9 1945

19

S. J. LEWIS

Scout