

KANSAS


FORM 51 5M 11-44 PETROL

Morris County

Section 19 Township 17 Range 5E

Well No. #1 Novak

Company Nadel and Gusman

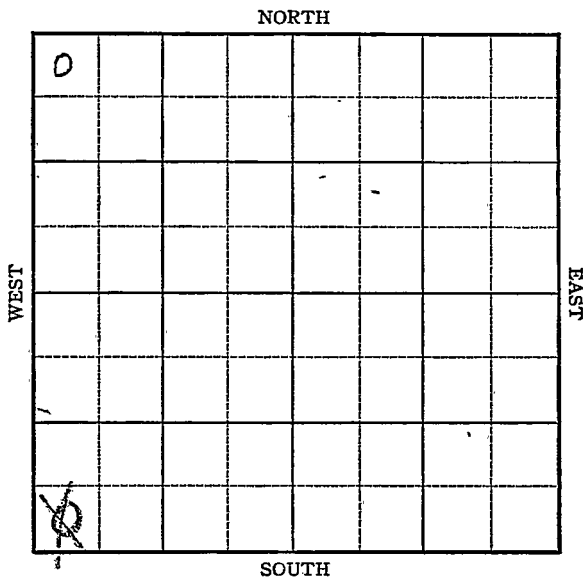

KANSAS

Morris County

Sec. ~~18~~ 30 Twp. 17 R. 5E

Well No. #1 Novak Farm

Nadel and Gusman Company

Lost Spring


330 Ft. from N. Line

~~330~~ Ft. from S. Line

 Ft. from E. Line

330 Ft. from W. Line

~~SW/c~~ NW/c

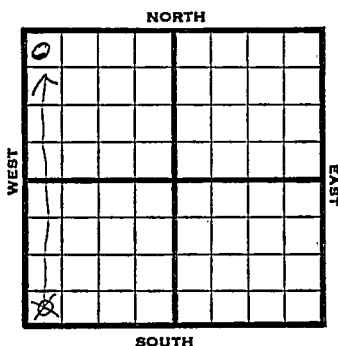

1946

Elev. 1444

R E P O R T

1/28

Location

1/31

"

2/7

"

2/14

12" - 204'

Drlg. 650'

2/21

10" - 1295'

Drlg. 1320'

2/28

8" - 1750' Drlg. 2065'

3/6

Miss. 2345

BD 2375'

ABANDONED

KANSAS


Kansas Pool Name Lost SpringMap No. 26 Sec. 19 Twp. 17 R. 5EWell No. 1 NovakNadel and Gusman Company

FIRST REPORT

Contractor

SW/c

SECTION PLAT

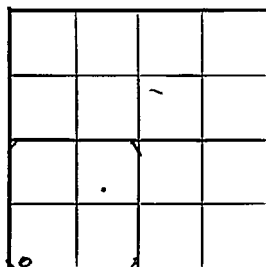 Ft. from N. Line330 Ft. from S. Line Ft. from E. Line330 Ft. from W. LineMorris CountyLocation XRig up

Drilling and Remarks:

RECORD

Cased in., ft.Sand Gas Oil Total Depth

PRODUCTION

1st 24 hrs. Nat. 1st 24 hrs. after shot Gas Cu. Ft.Dry Hole Abandoned

Date

JAN 23 194619S. J. LEWISScout

KANSASKansas Pool Name Lost SpringMap No. 26 Sec. 30 Twp. 17 R. 5EWell No. 1 NovakNadel and Gussman CompanyContractor

NW/c

SECTION PLAT

330 Ft. from N. Line Ft. from S. Line Ft. from E. Line330 Ft. from W. Line

0			

Morris County

RECORD

Location Cased in., ft.Rig up Sand

Drilling and Remarks:

Gas Oil

reported in

Total Depth

SW/c 19-17-5E

PRODUCTION

1st 24 hrs. Nat. 1st 24 hrs. after shot Gas Cu. Ft.Dry Hole Abandoned

Date

JAN 3 0 1946

19

S. J. LEWIS

Scout

KANSASKansas Pool Name Lost SpringMap No. 26 Sec. 30 Twp. 17 R. 5EWell No. 1 NovakNadel and Gussman

Company

ABANDONED

Contractor

NW/c

E. 1444
SECTION PLAT330


Ft. from N. Line

Ft. from S. Line

Ft. from E. Line

330

Ft. from W. Line

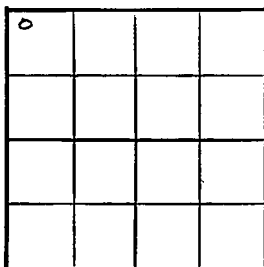Morris

Location _____

Rig up _____

Drilling and Remarks:

*Miss 2345***RECORD**

Cased _____ in., _____ ft.

Sand _____

Gas _____

Oil _____

Total Depth 2325**PRODUCTION**

1st 24 hrs. Nat. _____

1st 24 hrs. after shot _____

Gas _____ Cu. Ft.

Dry Hole _____

Abandoned _____

Date

MAR 6 1946 19S. J. LEWIS Scout