


Section 30 Township 17 Range 5E

Well No. #1 Bura

Company Musgrove Pet Corp.

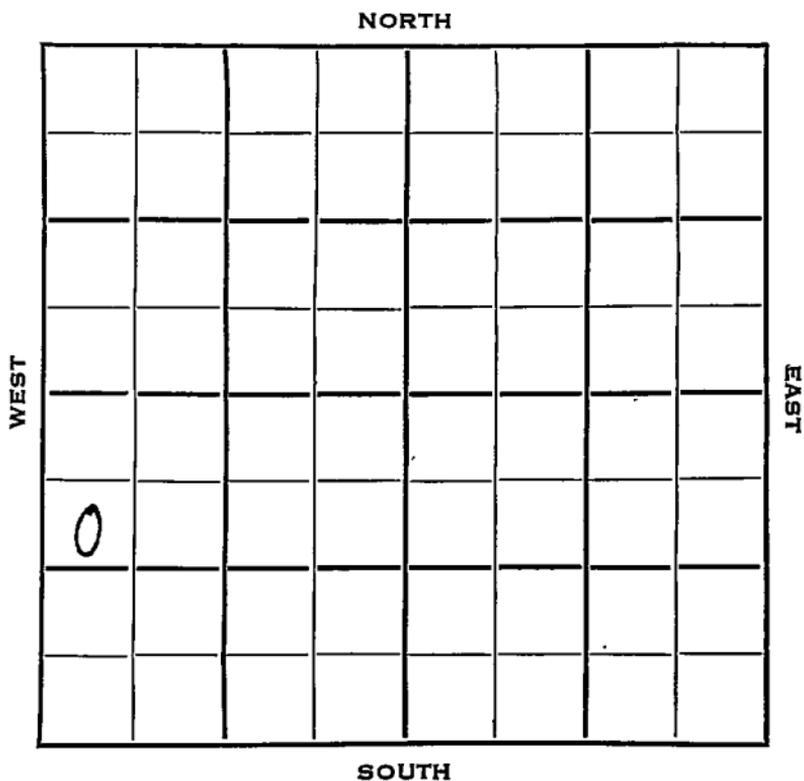

Morris
17

KANSAS
R. 5E

Sec. 30 Twp.

Well No. #1 Bura Farm

Musgrove Petr. Corp. Company

Contractor

Nelson


990 Ft. from N. Line

Ft. from S. Line

Ft. from E. Line

330 Ft. from W. Line

SW NW SW

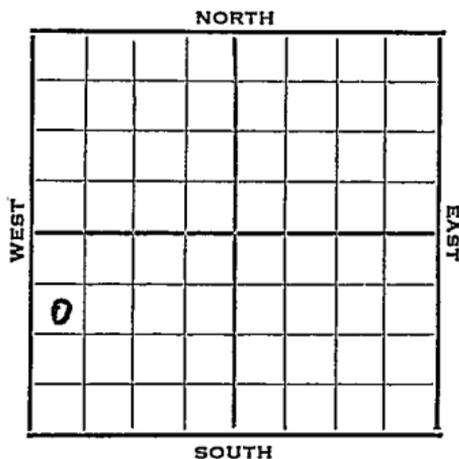

1953 Elev. 71458' REPORT

7/8 Spud 6-30-53
8" @ 195 w/125
IS-KC 1753, Cong 2278, MissCh 2282
DST 2284-90
60" R 660 gas + 32 slio + gcm, dd

9/2 Spud 6-30-53
Oil Well
TD 2313
8" @ 195
KC 1753, Cong 2278, Miss 2282
DST 2284-90, opn 1 hr., rec. 660'
gas, 32' so & gcm,
TD 2300
4" @ 2285
CO to 2297
S/5 go 5 gwph
DD 2306
DD 2313, sd-frac, S/10 bfph 50% wtr.
S/7 bfph 50% wtr. 12 hrs.
P/60 bopd 60 bw
Comp. 60 bopd 50% wtr.

COMPLETED

