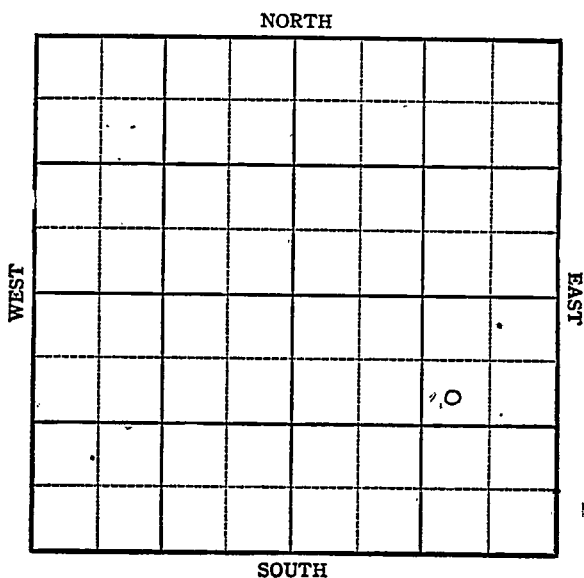


KANSASSection 30 Township 17 Range 5EWell No. 1 C. F. NelsonCompany Loriaux, et al

KANSAS

Sec. 30 Twp. Morris
17 R. 5E

Well No. #1 C.F. Nelson Farm

Loriaux et al Company


Lost Spring

990 Ft. from N. Line

Ft. from S. Line

990 Ft. from E. Line

Ft. from W. Line

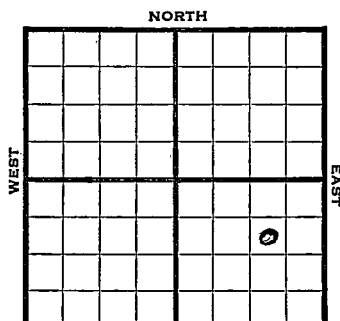

Blw. 1485

SW NE SE

1944

REPORT

8/30	Ponds
9/8	Mach.
9/13	Spud 91'
9/21	12" @ 200
	Drlg. 800
9/28	10" @ 830 8" @ 1607 Drlg. 1625
10/4	No report.
10/11	Drlg. 2190
10/18	Miss 2280-85 TD
	5" @ 2285 WOC
10/25	TD 2340 swb 25 oil plus 20 wtr a day
11/2	" " " " " " " " " "
11/8	Miss 2280
	5" @ 2285
	TD 2340

ABANDONED

Pool Name Lost SpringMap No. KANSAS Sec. 30 Twp. 17 R. 5EWell No. 1 C. F. NelsonLorianx et al Company

FIRST REPORT

Contractor

SW NE SE

SECTION PLAT

990 Ft. from N. Line Ft. from S. Line990 Ft. from E. Line Ft. from W. Line

Morris County

Location Rig up Drilling and Remarks:
Ponds

RECORD

Cased in., ft.Sand Gas Oil Total Depth

PRODUCTION

1st 24 hrs. Nat. 1st 24 hrs. after shot Gas Cu. Ft.Dry Hole Abandoned


Date

AUG 30 1944 19S. J. LEWIS Scout

Pool Name Lost SpringMap No. 26 Sec. 30 Twp. 17 R. 5EWell No. 1 C. F. NelsonLorjaux et al CompanyABANDONED Contractor

SW NE SE

SECTION PLAT

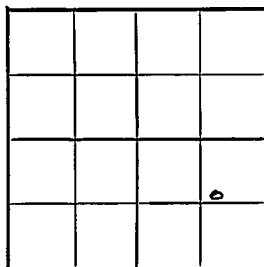990 Ft. from N. Line Ft. from S. Line990 Ft. from E. Line Ft. from W. LineMorrisLocation Rig up

Drilling and Remarks:

Miss 22805' to 2285.

RECORD

Cased in., ft.Sand Gas Oil Total Depth 2240

PRODUCTION

1st 24 hrs. Nat. 1st 24 hrs. after shot Gas Cu. Ft.Dry Hole Abandoned

Date

NOV 8 1944 19 S. J. LEWIS Scout