


Section 30 Township 17 Range 7E

Well No. #1 J. T. Veal

Company Stanolind

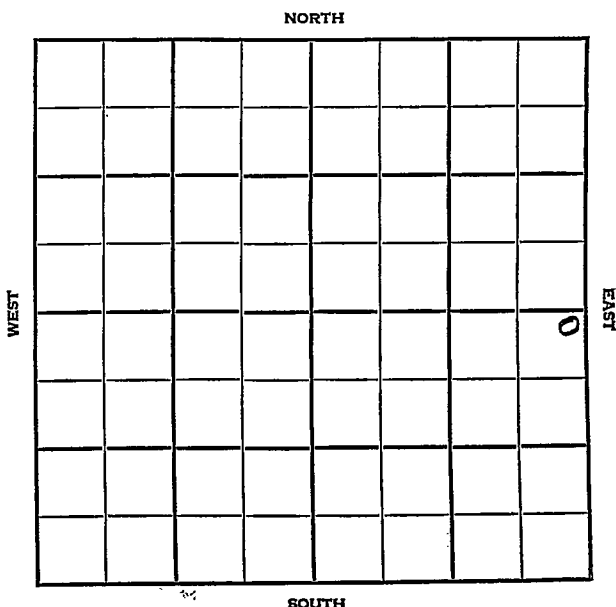

Morris

KANSAS

SEC.	TWP.	R.
30	17	7E

WELL NO.

J. T. Veal

FARM

COMPANY

Stanolind

CONTRACTOR

G-M-R

Wildcat

Ft. from N. Line


2600'

Ft. from S. Line

530'

Ft. from E. Line

Ft. from W. Line

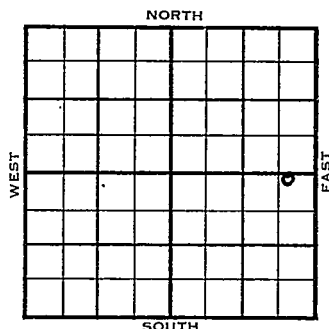

NE NE SE

	ELEVATION	REPORT
1955	1140'	

6/15

Location

7/20

Comm 6-16-55

H Cottonwood 304

Tr Neva 339

Dg Penn 537

B1 Howard 800

795

L Top 860

854

KC Deer Creek 938

~~9285~~ 935 ~~92~~

BKC Oread 1123

1120

Ge Heeb 1152

1154

G Tor 1171

1160

M Lans 1388

1384

BKC 1712

1716

Gr Wash

1861

G 1982

1982

TD 2005

8 5/8" @ 199/125 DST 1178-1260 open

1/2 hr. gas in 2 min, 434 mcfg in

15 min. Rec 210' sgcm 495/30"

DST 1700-50 open 25 min Rec 240'

sgcsw 290' sw 630-20" 5 1/2" @

1300 CO to 1265 24/1234-40 frac

1,250 mcfg 480# SP 1220 40/1126-

36 4 1/2 gmwph frac S/4 1/2 bwph

Comp shut in gas well 1,250 mcfgpd

1986
1716
145

County Morris Elev. _____
 Sec. 30 Twp. 17 Rge. 7E
 Company Stanolind
 Farm Name J. T. Veal No. 1

TOPS	DEPTH	LOG	DATUM	Loc. in Sec.
Anh.				NE NE SE
Tr.				2600' SL
Dg.				530' EL
BL.				Geol.
L.				Contr.
K.C.				G-K-R
B.K.C.				Pool
Ce.				Wildcat
C.				FIRST REPORT JUN 13 55
M.				
M.				
K.				
Mz.				
Me.				
V.				
S.				
S.				
A.				
R.				
PE.				
G.				
ED.				

Date Comm. _____
 Location _____

Co.

Lse.

T.

No.

Sec.

T.

R.

County Morris Elev. 1440
 Sec. 30 Twp. 17 Rge. 7E
 Company Stanolind
 Farm Name J. T. Veal No. 1

TOPS	DEPTH	LOG	DATUM
------	-------	-----	-------

Anh.			
Tp.			
H. <u>Cottonwood</u>	<u>304</u>		
Tr. <u>Nava</u>	<u>339</u>		
Dg. <u>Penn.</u>	<u>537</u>		
Bl. <u>Howard</u>	<u>800</u>	<u>795</u>	
L. <u>Top</u>	<u>860</u>	<u>854</u>	
K.C. <u>Deer Creek</u>	<u>938</u>	<u>935</u>	
B.K.C. <u>Ore ad</u>	<u>1123</u>	<u>1120</u>	
Ce. <u>Noah</u>	<u>1152</u>	<u>1154</u>	
C. <u>Top</u>	<u>1171</u>	<u>1160</u>	
M. <u>Lans</u>	<u>1388</u>	<u>1384</u>	
M. <u>BKC</u>	<u>1712</u>	<u>1716</u>	<u>276</u>
K.			
Mz.			
Ma.			
V.			
S.			
S.			
A.			
R.			
PE. <u>Cor Wash</u>		<u>1861</u>	<u>421</u>
G.	<u>1982</u>	<u>1982</u>	<u>542</u>
T.D.	<u>2005</u>		

Loc. in Sec.

NE NE SE

2600' SL

530' EL


Geol.

Contr.

G-M-R

Pool

Wildcat

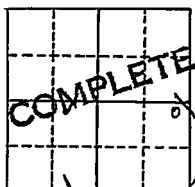

Date Comm. 6-16-55

JUL 20 1955

8 5/8" @ 199/125 DST 1178-1260 open

1/2 hr. gas in 2 min., 434 mcf/g in

15 min. Rec. 210' sgcm 495/30"

DST 1800-50 open 25 min. Rec. 240'

sgcsw 290' sw 630/20" 5 1/2" @ 1300

CO to 1265 24/ 1234-40 frac

1,250 mcf/g 480# SP 1220 40/ 1126-36

4 1/2 gmwph frac S/ 4 1/2 bwph

Comp. Shut in gas well 1,250 mcf/gpd