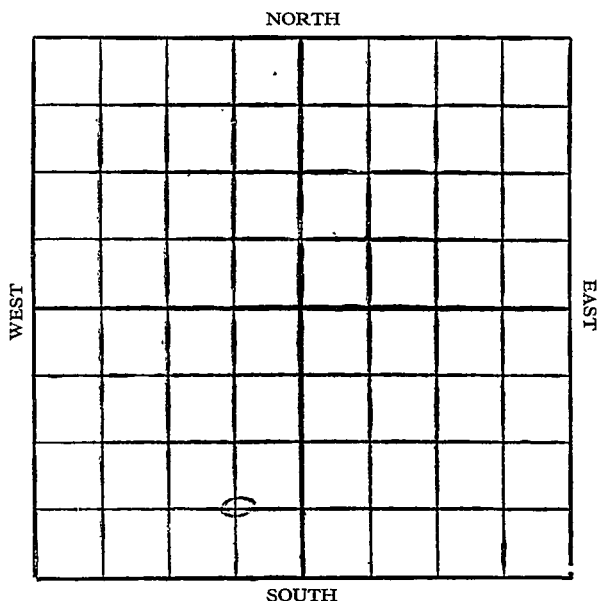


Map No. TS Sec. 30 Twp. 17 R. 15 EWell No. 1 - Jenkins Farm  
G. C. McBride Company

Location .....

Drilling Remarks

.....

.....

.....

.....

.....

.....

.....

.....

.....

.....

## RECORD

Cased ..... in. .... ft.

Sand .....

Gas .....

Oil .....

Total Depth .....

Rig Up .....

Drilling Remarks

.....

.....

.....

.....

.....

.....

.....

.....

.....

.....

## PRODUCTION

1st 24 hrs. Nat. ....

1st 24 hrs. after shot .....

Gas ..... cu. ft.

Dry Hole .....

Abandoned .....

Osage

Map No. Kansas Sec. 30 Twp. 17 R. 15Well No. 1 Ten Mine Farm  
G. C. McBride Company


NORTH

Ft. from N. Line

660 Ft. from S. Line660 Ft. from E. Line

Ft. from W. Line

WEST

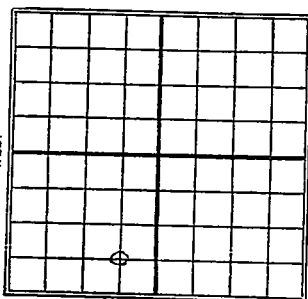

EAST

SOUTH

Date  
1927

## REPORT

|      |     |
|------|-----|
| 1/1  | Loc |
| 1/19 | —   |
| 1/26 | —   |
| 2/3  | —   |
| 2/10 | —   |
| 2/17 | —   |
| 2/24 | —   |
| 3/2  | —   |
| 3/9  | —   |
| 3/16 | —   |
| 3/24 | —   |
| 3/30 | —   |
| 4/7  | —   |
| 4/13 | —   |
| 4/20 | —   |
| 4/27 | —   |
| 5/5  | —   |
| 5/12 | —   |
| 5/18 | —   |
| 5/25 | —   |
| 6/1  | —   |
| 6/7  | —   |
| 6/15 | —   |

6/22 - Location

4/29 - Rig

7/7 - Spudding

7/13 - Drlg 468'

7/20 - S.D. 750

7/28 - Drlg 950

8/6 - Drlg 1630 - no sands or shows.

8/4 - \_\_\_\_\_  
8/10 - S.D. 1720 - for 8" -

8/18 - \_\_\_\_\_

8/24 - \_\_\_\_\_

9/1 - \_\_\_\_\_

9/7 - Top line 1712 - 1st break 1747-49  
H.F.W. - drlg 2025 still in line

9/12 - Top miss line 1712 - 2100 base  
sand 2180-83 - H.F.W. -


9/14 - Top line 1712  
1st bk. 1747-49 - H.F.W.  
Base line 2100'  
Sand 2180-85 - H.F.W.  
W.A. 2204

Map No. 1 Sec. 30 Twp. 17 R. 15 <sup>E</sup>

Well No. 1 Jenkins Farm

S. C. Mc Bride Company

NORTH

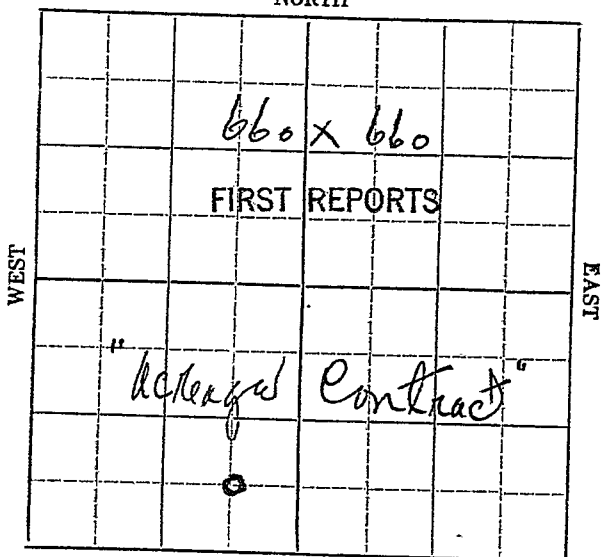

SOUTH

Location ✓

Rig up \_\_\_\_\_

Drilling and Remarks:

## RECORD

Cased \_\_\_\_\_ in., \_\_\_\_\_ ft.

Sand \_\_\_\_\_

Gas \_\_\_\_\_

Oil \_\_\_\_\_

Total Depth \_\_\_\_\_

## PRODUCTION

1st 24 hrs. Nat. \_\_\_\_\_

1st 24 hrs. after shot. \_\_\_\_\_

Gas \_\_\_\_\_ Cu. Ft.

Dry Hole \_\_\_\_\_

Abandoned \_\_\_\_\_

Date  
JAN 12 1927

CHAS. L. SHERWOOD

192

Scout

no map **KANSAS** 20 0509  
 Map No. Sec. 20 Twp. 17 R. 15  
 Well No. 1 *Jenkins*  
*S. C. Mc Bride*

Company

Contractor

## COMPLETED

## SECTION PLAT

Ft. from N. Line

660

Ft. from S. Line

660

Ft. from E. Line

Ft. from W. Line

ABANDONED

|  |   |  |  |
|--|---|--|--|
|  |   |  |  |
|  |   |  |  |
|  |   |  |  |
|  |   |  |  |
|  | 0 |  |  |

Location

## RECORD

Cased \_\_\_\_\_ in., \_\_\_\_\_ ft.

Sand \_\_\_\_\_

Gas \_\_\_\_\_

Oil \_\_\_\_\_

Total Depth 2204

Drilling and Remarks:

*200 line 1712*  
*1st Bk 1747-49 Afw*  
*200 line 2100*  
*Sand 2180-85 Afw*  
*2204*

## PRODUCTION

1st 24 hrs. Nat. \_\_\_\_\_

1st 24 hrs. after shot \_\_\_\_\_

Gas \_\_\_\_\_ Cu. Ft.

Dry Hole ☒Abandoned ☒

Date

SEP 14 1927

CHAS. L. SHERWOOD

192

Scout