


**KANSAS**

DX 78-1 Martin

Section 31 Township 17 Range 4E

Well No. #1 Reznicek

Company J. D. White & B. King

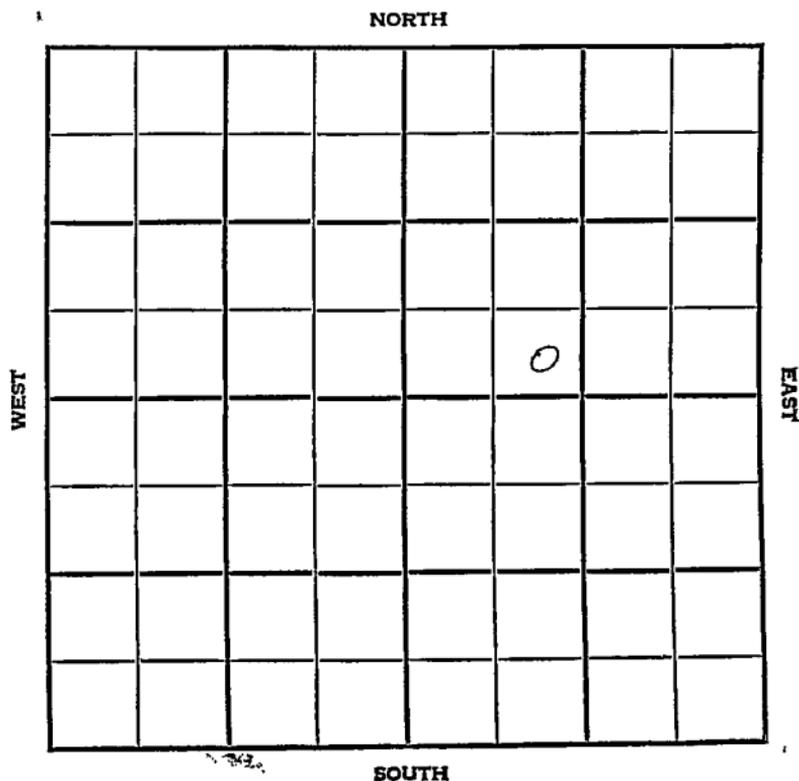

Marion

KANSAS

SEC.	## 31	TWP.	17	R.	4E
------	-------	------	----	----	----

WELL NO. #1 Reznicek FARM

COMPANY J.D. White & B.King

CONTRACTOR

Lost Springs


\_\_\_\_\_ FT. FROM N. LINE

\_\_\_\_\_ FT. FROM S. LINE

\_\_\_\_\_ FT. FROM E. LINE

\_\_\_\_\_ FT. FROM W. LINE

SE SW NE

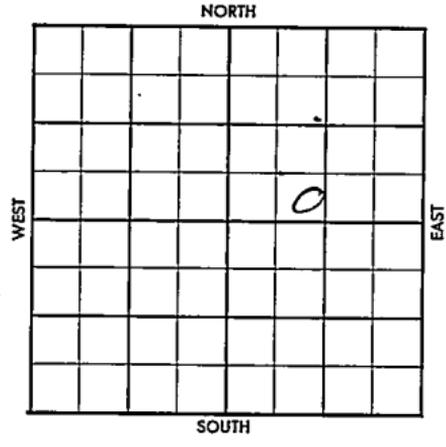

1956	ELEVATION 1466'	REPORT
------	-----------------	--------

8-8 Surface Set

**COMPLETED**

County Marion Elev. 1166  
 Sec. 31 Twp. 17 Rgs. 4E  
 Company J. D. White & B. King  
 Farm Name Reznicek No. 1

Co.

TOPS	DEPTH	LOG	DATUM
Anb.			
Tp.			
H.			
Tr.			
Dg.			
Bl.			
L.			
K.C.			
B.K.C.			
Ce.			
C.			
M.			
M.			
K.			
Mz.			
Me.			
V.			
S.			
S.			
A.			
R.			
Pe.			
G.			
T.D.			

Loc. in Sec. \_\_\_\_\_  
SE SW NE  
 Geol. \_\_\_\_\_  
 Contr. \_\_\_\_\_  
 Pool \_\_\_\_\_  
Lost Springs

Lse.



No.

Date Comm.

AUG 8 '56

surface set

Sec.

T.

3201 2 1 1956

R.

3201 2 1 1956

County Marion Elev. 1166  
 Sec. 31 Twp. 17 Rge. 4E  
 Company J. D. White & B. King  
 Farm Name Reznicek No. 1

Co.

TOPS	DEPTH	LOG	DATUM	Loc. in Sec.
Anh.				SE SW NE
Tr.				
H.				
Tr.				
Dg.				
Bl.				
L.				Geol.
K.C.				Contr.
B.K.C.				
Ce.				
C.				
M. <u>chat</u>	<u>2404</u>			Pool
M.				Lost Springs
K.				
Mz.				
Me.				
V.				
S.				
S.				
A.				
R.				
PE.				
G.				
				COMPLETE
TD.	<u>2470</u>			

Sec.

No.

Sec.

T.

R.

Date Comm.

surface set AUG 15 '56 8-8-56

858 160/100 5 1/2 2470/

AUG 22 '56 ✓ AUG 29 '56 WOCT SEP 5 '56

CO SEP 12 '56 PF 2418-23 FRAC

5 Bwp h + 1 1/2 Bwp h

est P. 25 Bwp d + 50 Bwp d