

KANSAS

Marion


FORM 51 5M 10-41 PETROL

Section 32 Township 17 Range 4-E

~~#4~~

Well No. #2 Novak

Company Ring-Mac

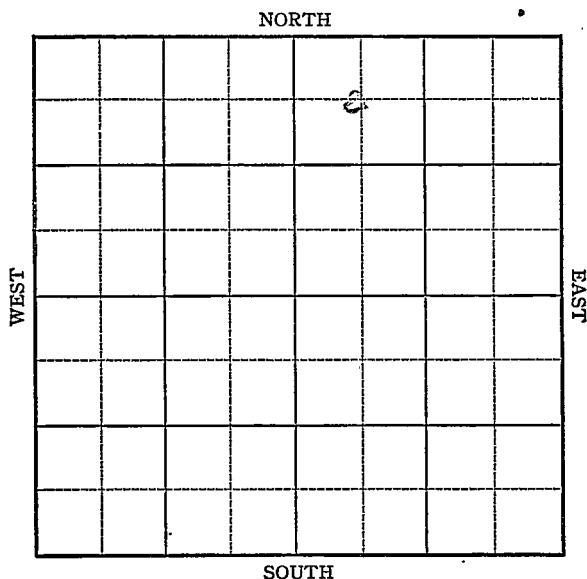

KANSAS

Marion

Sec. 32 Twp. 17 R. 4-E

Well No. #2 Novak Farm

Ring-Mac Company

Lost Spring Pool


660 Ft. from N. Line

 Ft. from S. Line

 Ft. from E. Line

660 Ft. from W. Line

C NW NE

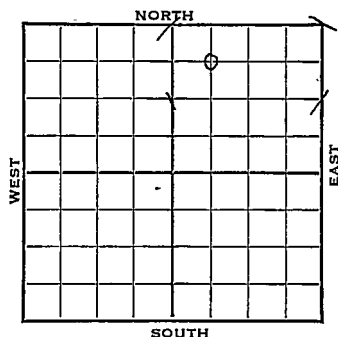

1942

REPORT

12/16 Location

12/22 10" @ 116'
Drlg. 710'

12/29 Drlg. 970

1943

1/6 2350 SD

1/13 Miss. 2393-96 TD
7" casing set 2396' RUST

1/20 Drilled plug SSO Shut for Weather.

1/27 TD 2413-199' Fluid.

2/3 To squeeze off.

2/10 TD 2421' SD

2/17 Miss. 2395

7" @ 2396'

T.D. 2427'

Pump 5 bbls oil plus 50 water 15 hrs.
D&A

ABANDONED

KANSAS

Map No. 26 Sec. 32 Twp. 17 R. 4EWell No. 2 Novak

Ring-Mac


Company

FIRST REPORT

Contractor

C NW NE

SECTION PLAT

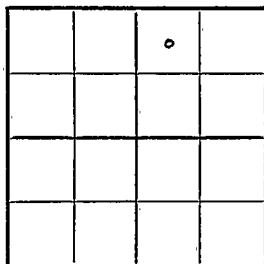660 Ft. from N. Line Ft. from S. Line Ft. from E. Line660 Ft. from W. Line

LOST SPRING POOL

Location XXXRig up

Drilling and Remarks:

RECORD

Cased in., ft.Sand Gas Oil Total Depth

PRODUCTION

1st 24 hrs. Nat. 1st 24 hrs. after shot Gas Cu. Ft.Dry Hole Abandoned

Date

DEC 16 1942 19

S. J. LEWIS Scout

no wait

Disc Small Maps	<i>One</i>
Cards	<i>Beats</i>
Tracing	<i>MB</i>
France Map	<i>✓</i>
Scarborough Map	<i>X</i>
Moody Map	<i>✓</i>
Geological Dept.	
Moody Flat Book	

KANSAS

Marion

Map No. 22 Sec. 32 Twp. 17 R. 4EWell No. 4 NovakRing-Mac CompanyCORRECTION Contractor

C NW NE

660 Ft. from N. Line Ft. from S. Line Ft. from E. Line660 Ft. from W. Line

SECTION PLAT

		0	

LOST SPRING POOL

Location Rig up

Drilling and Remarks:

Reported as

#2 Novak

RECORD

Cased in., ft.Sand Gas Oil Total Depth

PRODUCTION

1st 24 hrs. Nat. 1st 24 hrs. after shot Gas Cu. Ft.Dry Hole Abandoned

Date

JAN 6 1943 19

S. J. LEWIS Scout

no value

Misc Small Maps	One
Cards	Boat
Tracing	MB
France Map	
Scarborough Map	
Moody Map	
Geological Dept.	
Moody Flat Book	

Marion

KANSAS

Map No.

Sec.

32

Twp.

17

R.

4E

Well No. 4 Novak

Ring-Mac

Company

ABANDONED

Contractor

C NW NE

SECTION PLAT

660 Ft. from N. Line

Ft. from S. Line

Ft. from E. Line

660 Ft. from W. Line

LOST SPRING POOL

Location

Rig up

Drilling and Remarks:

Miss 2393

7" C 2396

Pump oil + 50 Wa 700
15 hrs.

JFA

RECORD

Cased in. ft.

Sand

Gas

Oil

Total Depth 2427

PRODUCTION

1st 24 hrs. Nat.

1st 24 hrs. after shot

Gas Cu. Ft.

Dry Hole

Abandoned

Date

FEB 17 1943

19

S. J. LEWIS

Scout

no

Misc Small Maps

Cards

Tracing

France Map

Scarborough Map

Moody Map

Geological Dept.

Moody Flat Book