

Marion

KANSAS

Sec. 32 Twp. 17 R. 4E

Well No. #1 Scully Farm

Slusser Drlg. Company

Slusser Drlg.- Contr. Contractor

Lost Springs Pool


 Ft. from N. Line

990' Ft. from S. Line

 Ft. from E. Line

990' Ft. from W. Line

NE SW SE

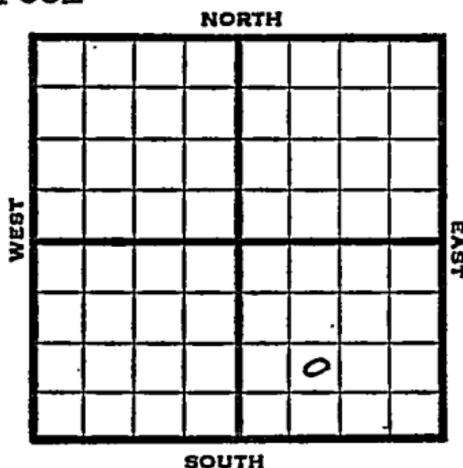

1951 Elev. 1467' REPORT

1/31 RUR

2/21 Spud 1-31-51
 Oil well TD 2410
 8" @125
 Miss. 2394-96
 5" @2395
 TD 2410 test water SP 2407
 Comp. 25 bopd

COMPLETED

FEB 2



Scout Cards
Land Small Map
Land Wall Map
Tracings
Large Map
Pierre Map
Misc.

Dirig. Data

Scout Cards *m.m.*

FEB 26 1951

Land Small Map

Land Wall Map

Tracings

France Map

Pierce Map

Misc.

Drig. Data