
FORM 51 5M BRIX KANSAS

Marion

Section 32 Township 17 Range 4E

Well No. #3 Stuchlik

Company Adair & Morton

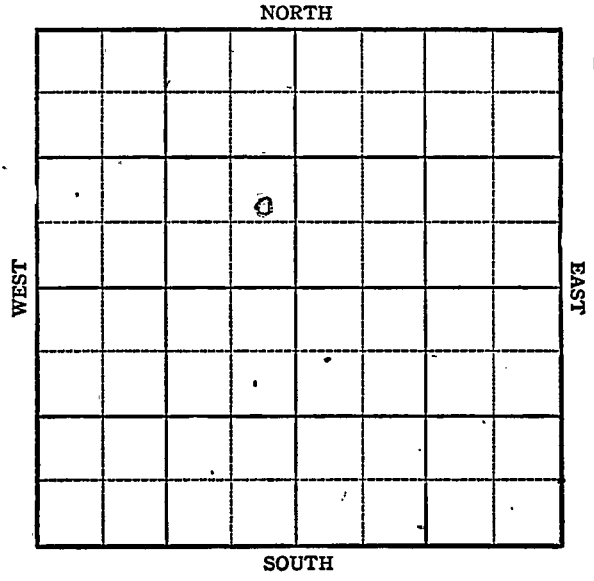

6

FORM 252-A
5M 3-44 PETROL

KANSAS

Marion

Sec. 32 Twp. 17 R. 4E

Well No. #3 Stuchlik Farm

Adair & Morton Company


Lost Spring

1530' Ft. from N. Line

_____ Ft. from S. Line

330' Ft. from E. Line

_____ Ft. from W. Line

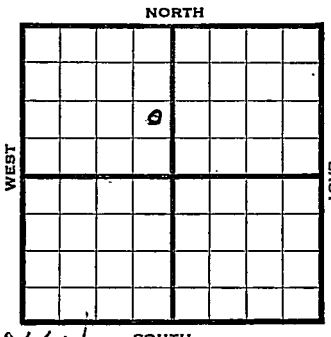

NE SE NW

1944	Elev. 1473 REPORT
6/21	8" @ 117 Drlg. 1620
6/28	Miss 2386-86½ TD 5" : 2386 RUST
7/12	Chat 2386 5" @ 2386 Pump 20 Pot Gravity 36.0 TD 2399

COMPLETED

FORM PE 200 BKS 1 44 PETROL

KANSAS

Pool Name Lost Spring

Map No. 26 Sec. 32 Twp. 17 R. 4E

Well No. 3 Stuchlik

Adair & Morton Company

FIRST REPORT Contractor

C E L SE NW

1530 Ft. from N. Line


Ft. from S. Line

330 Ft. from E. Line

Ft. from W. Line

Marion

SECTION PLAT

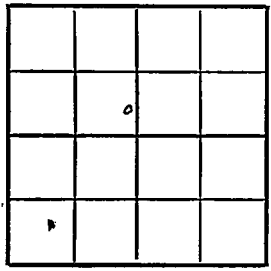

Location

Rig up

Drilling and Remarks:

8" - 117

Drlg. 1620

RECORD

Cased in., ft.

Sand

Gas

Oil

Total Depth

PRODUCTION

1st 24 hrs. Nat.

1st 24 hrs. after shot

Gas Cu. Ft.

Dry Hole

Abandoned

Date

JUN 2 1 1944 19

S. J. LEWIS Scout

FORM 26 200 BKS. 2-44 PETROL

KANSAS

Pool Name Lost Spring

Map No. 20 Sec. 32 Twp. 17 R. 4E

Well No. 3 Stuchlik

Adair & Morton Company

COMPLETED Contractor

C E L SE NW


1530 Ft. from N. Line

Ft. from S. Line

330 Ft. from E. Line

Ft. from W. Line

SECTION PLAT

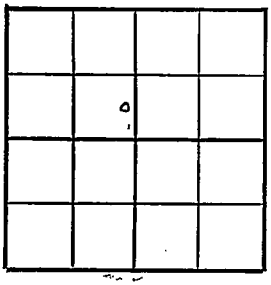

Marion County

Location

Rig up

Drilling and Remarks:

Okla 2386

5" @ 2386

Pump 20 BO

36° Gr

RECORD

Cased in., ft.

Sand

Gas

Oil

Total Depth 2388

PRODUCTION

1st 24 hrs. Nat.

1st 24 hrs. after shot

Gas Cu. Ft.

Dry Hole

Abandoned

Date

JUL 12 1944 19

S. J. LEWIS Scout