
FORM 51 10M 8-47

KANSAS Marion

Section 33 Township 17 Range 4E

Well No. #6 Hajek

Company Ward McGinnis
Lost Spring Pool

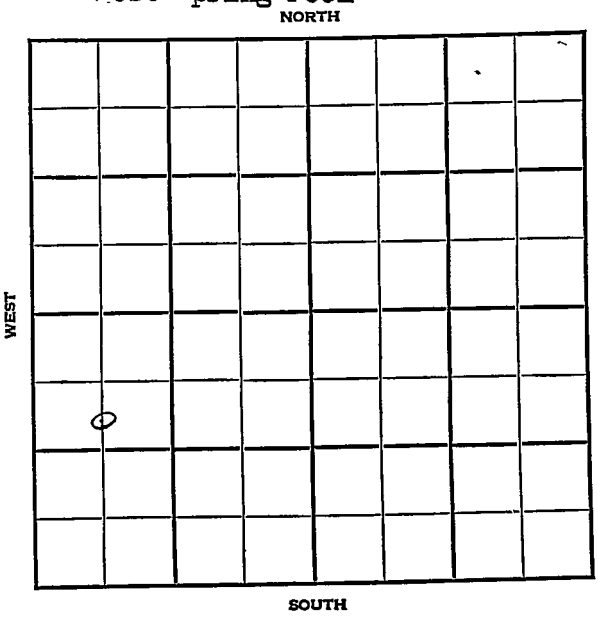

12

FORM 252-A
5M 12-45 PETROL

KANSAS — Marion County

Sec. 33 Twp. 17 R. 4E

Well No. #6 Hajek Farm

Ward Ginnis Company

Lost Spring Pool


990 Ft. from N. Line

Ft. from S. Line

Ft. from E. Line

660 Ft. from W. Line

C S L NW SW

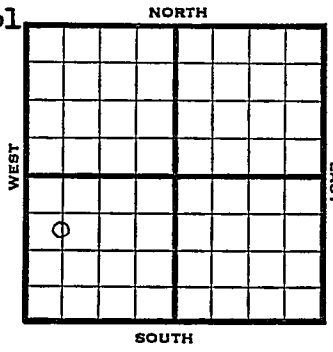

1948	Eli 1492' REPORT
4/21	Machine
4/28	"
5/5	"
5/12	"
5/19	12" @ 129' Drlg. 500'
5/26	Drlg. 935'
6/1	10" @ 1230' Drlg. 1500'
6/9	8"@ 1675' CO.
6/16	Drlg. 1830'
6/23	Drlg 2300'
6/29	"
7/14	TD 2433 Miss 2402' 5"@ 2407' 30 qts. Pump 12 oil / 20 W Pot 36° Grl Comp. **COMPLETED**

Form 26—200 Bks.—1-48—Palace

Kansas

Lost Spring Pool

Map No. _____ Sec. 33 Twp. 17 R. 4E

Well No. 6 Hajek

Ward McGinnis Company

FIRST REPORT Contractor

C S L NW SW


990 Ft. from N. Line

_____ Ft. from S. Line

_____ Ft. from E. Line

660 Ft. from W. Line

SECTION PLAT

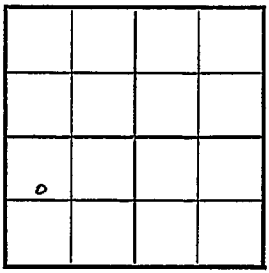

Marion County

Location _____

Rig up _____

Drilling and Remarks:

Machine

RECORD

Cased _____ in., _____ ft.

Sand _____

Gas _____

Oil _____

Total Depth _____

PRODUCTION

1st 24 hrs. Nat. _____

1st 24 hrs. after shot _____

Gas _____ Cu. Ft.

Dry Hole _____

Abandoned _____

Date

APR 21 1948 19____ S. J. LEWIS Scout

Form 26—200 Bks.—1-48—Palace

Kansas

Lost Spring Pool

Map No. 26 Sec. 33 Twp. 17 R. 4E

Well No. 6 Hajek

Ward McGinnis

Company


COMPLETE

Contractor

C S L NW SW

El. 1492

SECTION PLAT

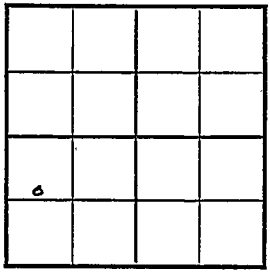

990 Ft. from N. Line

Ft. from S. Line

Ft. from E. Line

660 Ft. from W. Line

Marion County

Location

Rig up

Drilling and Remarks:

Miss 2402

5" @ 2402

809 fa

Perf 12 oil + 20 W

Pot

36 7 Gr

RECORD

Cased in., ft.

Sand

Gas

Oil

Total Depth 2433

PRODUCTION

1st 24 hrs. Nat.

1st 24 hrs. after shot

Gas Cu. Ft.

Dry Hole

Abandoned

Date

JUL 14 1948 19

S. J. LEWIS Scout