


Section 33 Township 17 Range 4E

Well No. #5 Kaiser

Company Ward McGinnis

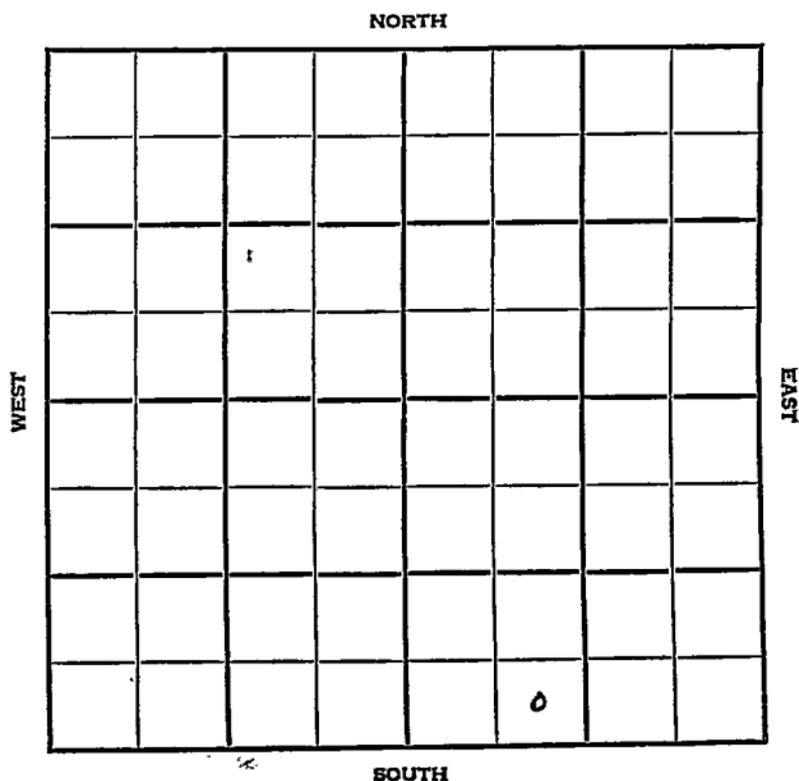

Marion

KANSAS

SEC.	33	TWP.	17	R.	1E
------	----	------	----	----	----


WELL NO. #5 Kaiser FARM

COMPANY Ward McGinnis

CONTRACTOR

Lost Springs Pool

\_\_\_\_\_ Ft. from N. Line  
 330  
 \_\_\_\_\_ Ft. from S. Line  
 \_\_\_\_\_ Ft. from E. Line  
 990  
 \_\_\_\_\_ Ft. from W. Line

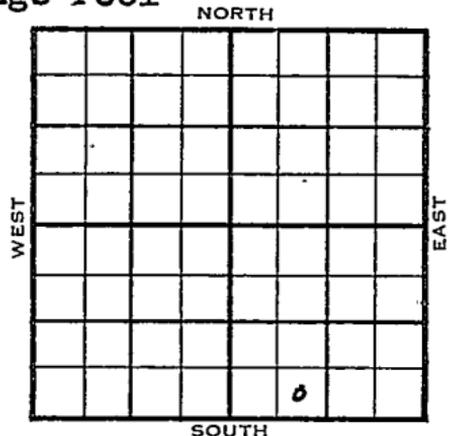

SE SW SE

1954	ELEVATION 1461'	REPORT
------	--------------------	--------

11/23 Spud 11-21-54  
 8" @ 120'  
 Drlg. 590'

12/29 Spud 11-21-54  
 Oil Well  
 TD 2366'  
 8" @ 138'  
 Miss 2357'  
 TD 2364'  
 5" @ 2363'  
 Lans 1830'  
 CO DD 2366' sd-oil-frac.  
 Comp 10 bopd.

**COMPLETED**



