

Morris

KANSAS

SECTION 33 TOWNSHIP 17 RANGE 5E


WELL NO. #1 Oscar Carlson

COMPANY Frank Strait Drlg.

NORTH

WEST

EAST

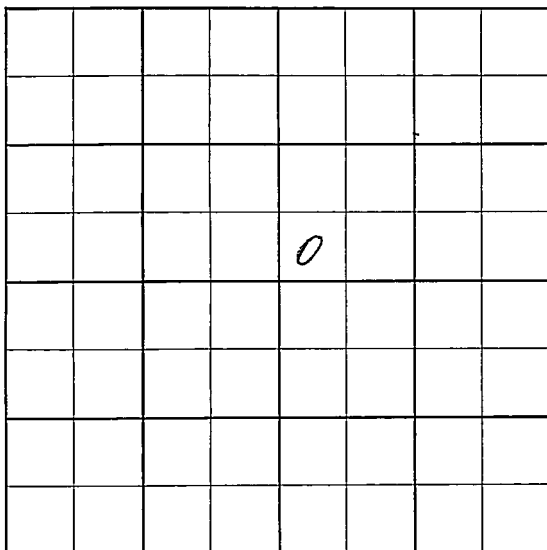

SOUTH

Morris

KANSAS

SEC. 33	TWP. 17	R. 5E
------------	------------	----------

WELL NO.

#1 Oscar Carlson

FARM

COMPANY

Frank Strait Drlg.

CONTRACTOR

Co. Tools

WILDCAT


_____ Ft. from N. Line

_____ Ft. from S. Line

_____ Ft. from E. Line

_____ Ft. from W. Line

SW SW NE

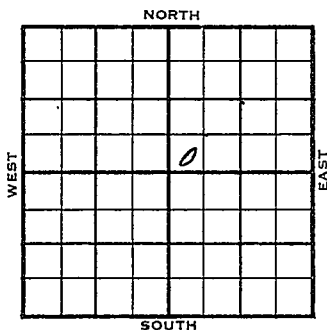

1956

ELEVATION

1480'

REPORT

5-9

Location

5-23

Spud 5-16-56

Drlg. 350'

5-29

13 3/8" @375 Fishing @1225'

6-6

Drlg. 1245'

6-13

Drlg. 1925

6-20

7" @2185 sso @ 2225

D & A

M. 2225', Cherty. 223363',

TD 2280'

ABANDONED

County

Morris

Elev.

Sec.

33

Twp.

17

Rge.

SE

Company

Frank Strait Drlg.

Farm Name

Oscar Carlson

No.

1

Co.

Lse.

No.

Sec.

T.

R.

TOPS

DEPTH

LOG

DATUM

Loc. in Sec.

Anh.

Tp.

H.

Tr.

Dg.

Bl.

L.

K.C.

B.K.C.

Ce.

C.

M.

M.

K.

Mz.

Mq.

V.

S.

S.

A.

R.

P.E.

G.

T.D.

SW SW NE

Geol.

Contr.

Co. tools

Pool

Wildcat

FIRST REPORT
 MAY 9 '56

Date Comm.

Location

MAY 11 1956

M. G.

No County Map

County Morris Elev. 1480
 Sec. 33 Twp. 17 Rge. 5E
 Company Frank Strait Drlg.
 Farm Name Oscar Carlson No. 1

TOPS	DEPTH	LOG	DATUM	Loc. in Sec.
Anh.				SW SW NE
Tr.				
H.				
Tr.				
Dg.				
Bl.				
L.				Geol.
K.C.				Contr.
B.K.C.				Co. tools
Ce.				Pool
C.				Wildcat
M.	2225			
M. <i>chert</i>	2233-63			
K.				
Mz.				
Ma.				
V.				
S.				
S.				
A.				
R.				
PE.				
G.				
T.D.	2280			

JUN 20 1956

Date Comm.

Location

MAY 16 '56 ✓

MAY 23 '56

5-16-56

D 350

MAY 29 '56

13 3/8 @ 375 Fishing @ 1225

JUN 6 '56

1245

JUN 13 '56

1925

JUN 20 '56

7" @ 2185

550

@ 2225

D & A