


Marion

Map No. 15 Sec. 33 Twp. 17 R. 4

Well No. 1-Hausper Farm
Franka et al Company

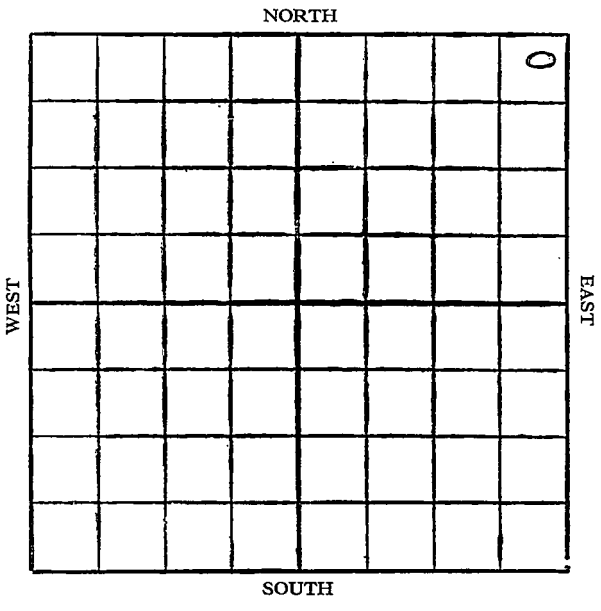

Location

Drilling Remarks

.....

.....

Rig Up.....

Drilling Remarks

.....

.....

RECORD

Cased..... in. ft.

Sand

Gas

Oil

Total Depth.....

PRODUCTION

1st 24 hrs. Nat.....

1st 24 hrs. after shot.....

Gas..... cu. ft.

Dry Hole.....

Abandoned.....

marion

Map No. 15 Sec. 33 Twp. 17 R. 4


Well No. 1-Houser Farm
Franks et al Company

250 Ft. from N. Line

_____ Ft. from S. Line

250 Ft. from E. Line

_____ Ft. from W. Line

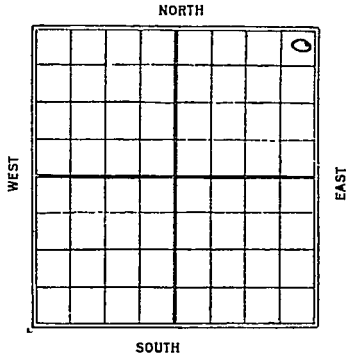

1926

Date

REPORT

12/30 Location

~~1927~~

1/6 same

1/13 _____

1/19 Rig

1/26 Spud 200

2/3 same

2/10 Drlg 1000

2/17 10" 1465

4/24 S.D. 1900 for 8"

3/2 Drlg 2105

3/9 Top Chat 2435 show oil
2445-55

3/16 Top silicious line 2630 show
gas - running 5"

3/24 Top 2435 - show oil 2445
to 55' silc. line 2630
show gas

D & A. 3680

Malcom

no KANSAS Map No. Sec. *33* Twp. *17* R. *4*

Well No. *1* *Houder*

FRANKS & al Company

Contractor

FIRST REPORTS

SECTION PLAT

250 Ft. from N. Line
Ft. from S. Line
250 Ft. from E. Line
Ft. from W. Line

			o
x			

Location

Rig up

Drilling and Remarks:

RECORD

Cased _____ in., _____ ft.
Sand _____
Gas _____
Oil _____
Total Depth _____

PRODUCTION

1st 24 hrs. Nat. _____
1st 24 hrs. after shot _____
Gas _____ Cu. Ft.
Dry Hole _____
Abandoned _____

Date
DEC 30 1926

CHAS. L. SHERWOOD
Scout

no map **KANSAS** *Malcom* 661
Map No. _____ Sec. *23* Twp. *17* R. *4*

Well No. *1 Houser*

Flonka et al Company

Contractor

COMPLETED

SECTION PLAT

250 Ft. from N. Line
_____ Ft. from S. Line
250 Ft. from E. Line
_____ Ft. from W. Line

			<i>0</i>

ABANDONED

Location _____

Rig up _____

Drilling and Remarks:

Top 2435'
show oil 2445-55'
file line 2620'
show gas
DD# 2680

RECORD

Cased _____ in., _____ ft.
Sand _____
Gas _____
Oil _____
Total Depth *2680*

PRODUCTION

1st 24 hrs. Nat. _____
1st 24 hrs. after shot. _____
Gas _____ Cu. Ft.
Dry Hole
Abandoned

Date
MAR 24 1927

CHAS. L. SHERWOOD

192 _____ Scout

MAP No. _____ SEC. 33 TWP. 17S. 4E

WELL No. 1 House

Franker et al COMPANY

CONTRACTOR

no wall map

SECTION PLAT

			0

_____ FT. FROM N. LINE

_____ FT. FROM S. LINE

_____ FT. FROM E. LINE

_____ FT. FROM W. LINE

LOCATION _____

RIG UP _____

DRILLING AND REMARKS:

RECORD

CASED _____ IN., _____ FT.

SAND _____

GAS _____

OIL _____

TOTAL DEPTH. 76 80

PRODUCTION

1ST 24 HRS. NAT. _____

1ST 24 HRS. AFTER SHOT _____

GAS _____ CU. FT.

DRY HOLE

ABANDONED

DATE

Apr 5 192 7

SCOUT