


OSAGE CO.

Map No. 15 Sec. 33 Twp. 17 R. 14EWell No. 1 - Barnett FarmJohn Stark Company

NORTH

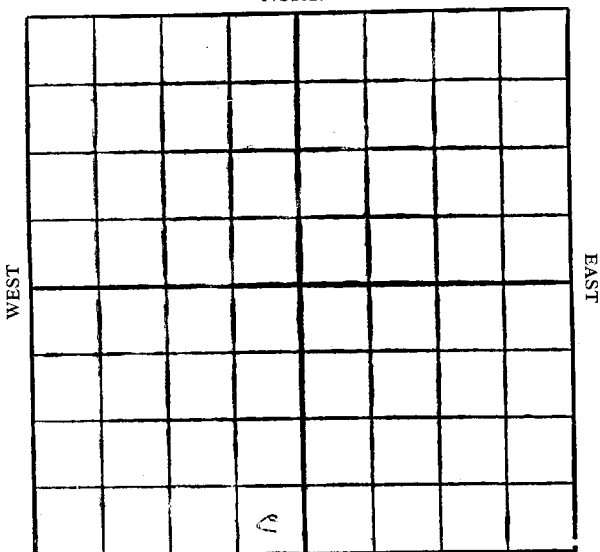

SOUTH

Location

Drilling Remarks

.....

.....

RECORD

Cased in. ft.

Sand

Gas

Oil

Total Depth

Rig Up

Drilling Remarks

.....

.....

PRODUCTION

1st 24 hrs. Nat.

1st 24 hrs. after shot

Gas cu. ft

Dry Hole

Abandoned


Osage Co

Map No. Kansas Sec. 33 Twp. 17 R. 14^EWell No. 1-Barnett Farm
John Stark Company

Ft. from N. Line

250 Ft. from S. Line250 Ft. from E. Line

Ft. from W. Line

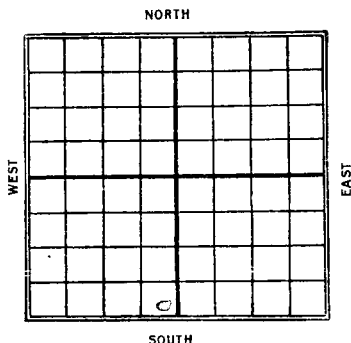

Date

REPORT

19271/12 Location1/19 same1/26 —2/3 —2/10 —2/17 —4/24 —3/2 —3/9 —3/16 —3/24 —3/30 —4/7 Machine4/13 —4/20 —4/27 —5/5 —5/12 —5/18 —5/25 —6/1 —6/7 —

6/22 - Machine
7/29 - Spudding
7/7 - " 300'
7/13 - S.D. 870' for 10"
7/20 - Drelg 1050-
7/28 - _____
8/4 - S.D. 1300 - titles
8/10 - _____
8/18 - _____
8/24 - Drelg 1623-
9/1 - _____
9/7 - Top line 1777 - 1st break 1845.
1847 - H.F.W. - S.D. orders.
9/14 - Top line 1777
1st bk. 1845-47
D. & A. 1847

Osage Co

KANSAS

Map No.

Sec

33

Twp.

17

R.

14^E


Well No.

Farm

John Stack

Company

NORTH

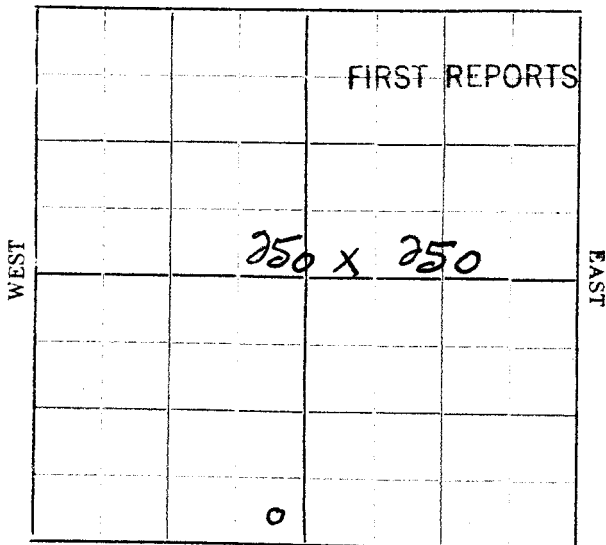

SOUTH

Location ✓

Rig up

Drilling and Remarks:

RECORD

Cased in., ft.

Sand

Gas

Oil

Total Depth

PRODUCTION

1st 24 hrs. Nat.

1st 24 hrs. after shot

Gas Cu. Ft.

Dry Hole

Abandoned

Date

JAN 12 1927

192

CHAS. L. SHERWOOD

Scout

Map No. KANSAS Sec. 33 Twp. 17 R. 14

Well No. 1 BARNETT

Company

Contractor

COMPLETED

SECTION PLAT

_____ Ft. from N. Line

250

_____ Ft. from S. Line

250

_____ Ft. from E. Line

_____ Ft. from W. Line

ABANDONED

Location _____

Rig up _____

Drilling and Remarks:

200' Run 1777

1st 24 1845-47

1847 1847

RECORD

Cased _____ in., _____ ft.

Sand _____

Gas _____

Oil _____

Total Depth 1847

PRODUCTION

1st 24 hrs. Nat. _____

1st 24 hrs. after shot _____

Gas _____ Cu. Ft.

Dry Hole ☒

Abandoned ☒

Date

SEP 14 1927

192

CHAS. L. SHERWOOD

Scout