
FORM 51 25M 8-50 WESTERN

Marion KANSAS

Section 34 Township 17 Range 4E

Well No. #1 Henke

Company Rex & Morris

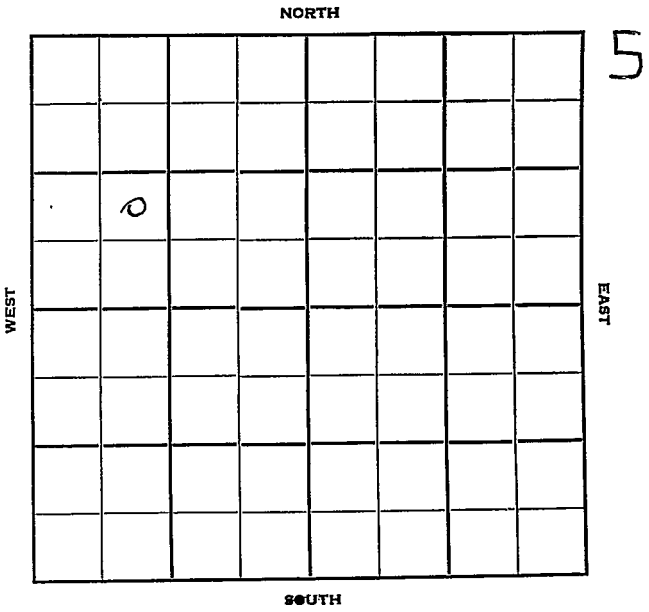

FORM 252-B
10M 10-50 PETROL

Marion KANSAS

Sec. 34 Twp. 17 R. 4E

Well No. #1 Henke Farm

Rex & Morris Company

Slusser Drlg. - Contr. Contractor

Lost Springs Pool


_____ Ft. from N. Line

990' Ft. from S. Line

_____ Ft. from E. Line

990' Ft. from W. Line

NE SW NW

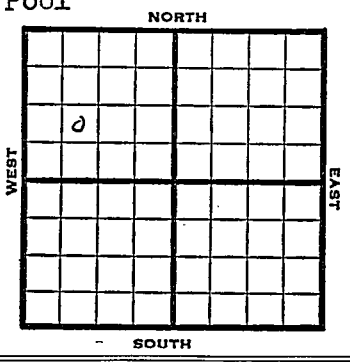


| 1950 | Elev 1485' REPORT |
|---|---|
| 12/6 | Spud 11-30-50<br>8" @ 108'<br>Drlg. 1871' |
| 12/20 | 8" @ 108<br>Miss 2392-94<br>5" @ 2392<br>TD 2453<br>FU with water<br>D&A<br>ABANDONED |

FORM 275 FOR SALE BY KANSAS BLUE PRINT CO.


County Marion State Kansas

Sec. 34 (Blk. Twp.) 17 (Sur. Rge.) 4E Map No.

Operator Rex & Morris

Well No. 1 Farm Henke

Elev. Location NE SW NW

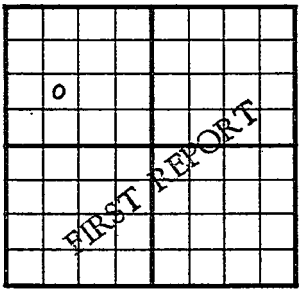


990 Ft. From S Line NW

990 Ft. From W Line Quarter

1st. Report DEC 6 1950

Completion

Remarks Slusser Drlg. - Contr.

Spudding Date 11-30-50

Drlg. Data Lost Springs Pool

8" @ 108 drlg. 1871

J. E. TYRA

FORM 275 FOR SALE BY KANSAS BLUE PRINT CO.


County Marion State Kansas

Sec. 34 (Blk. Twp.) 17 (Sur. Rge.) 4E Map No.

Operator Rex & Morris

Well No. 1 Farm Henke

Elev. 1485 Location NE SW NW

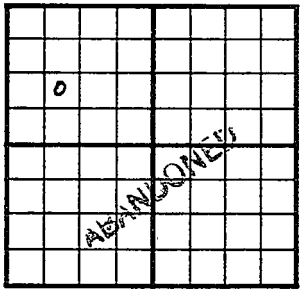


990 Ft. From S Line NW

990 Ft. From W Line Quarter

1st. Report

Completion DEC 20 1950

Remarks Lost Springs Pool
Slusser Drlg. - Contr.

Spudding Date 11-30-50

Drlg. Data D & A TD 2453

8" @ 108 Miss. 2392-94 5" @ 2392

TD 2453 FU with water

D & A

J. E. TYRA