

KAN ¹⁵

Marion

Sec. 34 Twp. 17 R. 4E

Well No. #3 Kaiser Farm _____
Veeder Supply. Company _____


Lost Spring

_____ Ft. from N. Line

330 Ft. from S. Line

330 Ft. from E. Line

_____ Ft. from W. Line

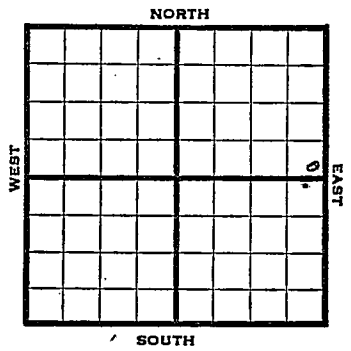

SE NE

1947 Elev. 1469 REPORT

9/10 8" @ 110
Drlg. 250

9/17 Mississippi 2350'
TD 2359'
5" @ 2354'
RUST

9/24 " "

10/1 Wiss 2350
5-1/2" @ 2354
TD 2409

ABANDONED

Map No. _____ Sec. 34 Twp. 17 R. 4E

Well No. 3 Kaiser

Veeder Supply Company

FIRST REPORT

Contractor

SE NE


SECTION PLAT

_____ Ft. from N. Line

330 Ft. from S. Line ✓

330 Ft. from E. Line

_____ Ft. from W. Line

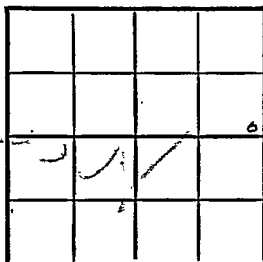

Marion County

Location _____

Rig up _____

Drilling and Remarks:

8" @ 110

drlg. 250

RECORD

Cased _____ in, _____ ft.

Sand _____

Gas _____

Oil _____

Total Depth _____

PRODUCTION

1st 24 hrs. Nat. _____

1st 24 hrs. after shot _____

Gas _____ Cu. Ft.

Dry Hole _____

Abandoned _____

Date

SEP 10 1947 19

S. J. LEWIS

Scout

