


Section 34 Township 17 Range 4E

Well No. #6 / #5 Kaiser

Company Veeder Supply

Lost Spring NORTH

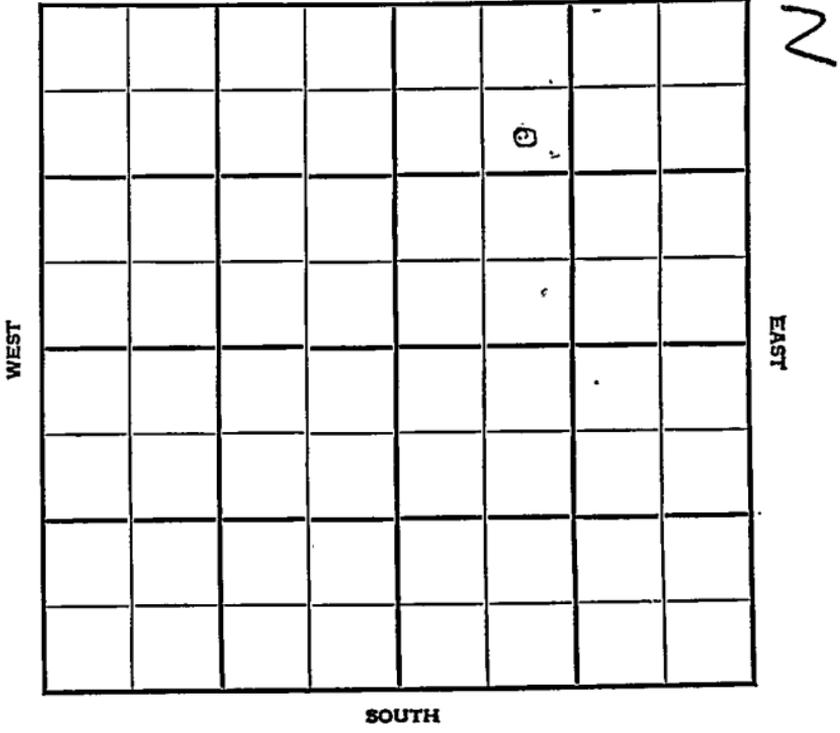

KANSAS

Marion



Sec. 34 Twp. 17 R. 4E


Well No. #6 ~~#8~~ Kaiser Farm

Veeder Supply Company

Lost Spring Pool

NORTH

~~880~~ ⁸⁸⁷ Ft. from N. Line

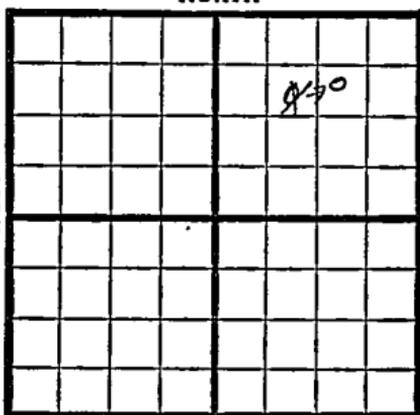

Ft. from S. Line

1200 Ft. from E. Line

~~880~~ Ft. from W. Line

SOUTH

SW NE NE
SE NW NE

1948

Elev. 1463' REPORT

- 1/7 Location
- 1/14 8" @ 212'
Drlg 1670'
- 1/21 SD
- 1/26 . "
- 2/4 "
- 2/11 "
- 2/18 "
- 2/25 Miss. 2340'
5" @ 2347'
Pump 50 Pot
36.0 Gr.
TD 2370'
Comp.

COMPLETED

Map No. _____ Sec. 34 Twp. 17 R. 4E

Well No. 5 Kaiser

Veeder Supply Company

FIRST REPORT Contractor

SE NW NE

SECTION PLAT

990 Ft. from N. Line

_____ Ft. from S. Line

_____ Ft. from E. Line

990 Ft. from W. Line

		o	

Marion County

Location X

Rig up _____

Drilling and Remarks:

RECORD

Cased _____ in., _____ ft.

Sand _____

Gas _____

Oil _____

Total Depth _____

PRODUCTION

1st 24 hrs. Nat. _____

1st 24 hrs. after shot _____

Gas _____ Cu. Ft.

Dry Hole _____

Abandoned _____

Date

JAN 7 1948 19

S. J. LEWIS Scout

Map No. 26 Sec. 34 Twp. 17 R. 4E

Well No. 6 Kaiser

Veeder Supply Company

CORRECTION Contractor

SW NE NE

SECTION PLAT

887 Ft. from N. Line

 Ft. from S. Line

1200 Ft. from E. Line

 Ft. from W. Line

			o

Marion County

Location

Rig up

Drilling and Remarks:

Reported

SE NW NE

RECORD

Cased in., ft.

Sand

Gas

Oil

Total Depth

PRODUCTION

1st 24 hrs. Nat.

1st 24 hrs. after shot

Gas Cu. Ft.

Dry Hole

Abandoned

Date

FEB 25 1948 19

S. J. LEWIS Scout

Map No. _____ Sec. 34 Twp. 17 R. 4E

Well No. 6 Kaiser

Veeder Supply Company

COMPLETE Contractor

SW NE NE

E. 1463
SECTION PLAT

			△

889 Ft. from N. Line

_____ Ft. from S. Line

1200 Ft. from E. Line

_____ Ft. from W. Line

Marion County

RECORD

Location _____

Cased _____ in., _____ ft.

Rig up _____

Sand _____

Drilling and Remarks:

Gas _____

Misc 2340

Oil

45 2370

Total Depth 2370

5" @ 2347

Pony 50 BX

96 2/2

PRODUCTION

1st 24 hrs. Nat. _____

1st 24 hrs. after shot _____

Gas _____ Cu. Ft.

Dry Hole _____

Abandoned _____

Date

FEB 25 1948 19 S. J. LEWIS Scout