


Section 34 Township 17 Range 4-E

Well No. #7 Kaiser

Company Veeder Supply

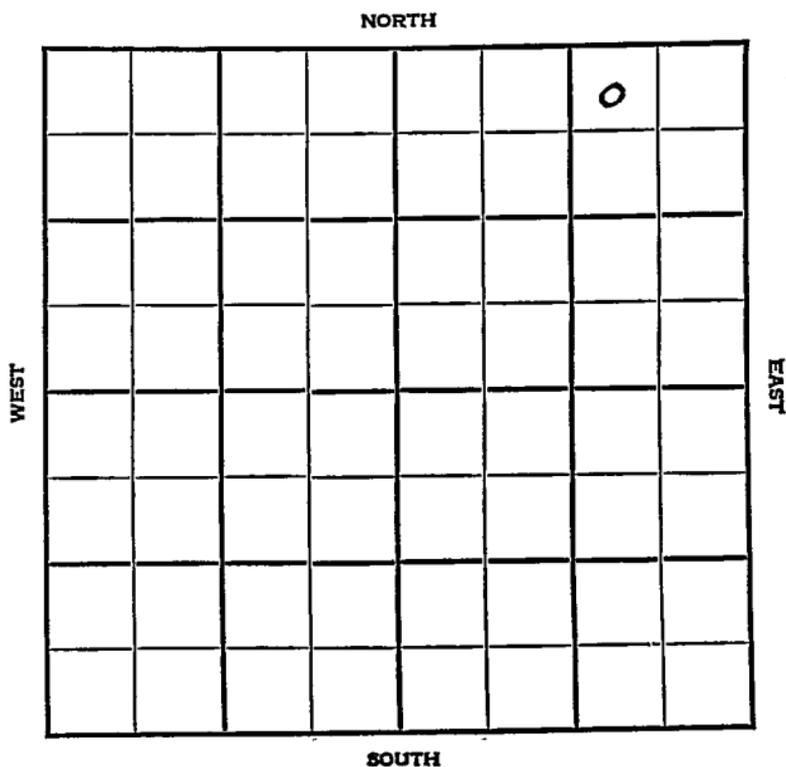

KANSAS

Marion

Sec. 34 Twp. 17 R. 4E

Well No. #7 Kaiser Farm

Veeder Supply Company

Lost Spring


330 Ft. from N. Line

_____ Ft. from S. Line

900 Ft. from E. Line

_____ Ft. from W. Line

NW NE NE

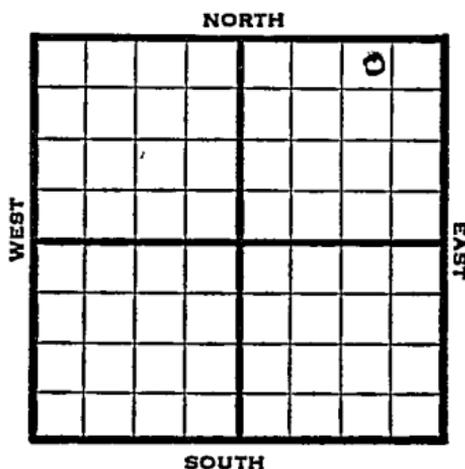

1948

REPORT

2/18

Miss. 2344'
2405' TD
5" @ 2351'
Water
D&A
TD 2405'

FIRST REPORT
of
ABANDONED

Map No. 26 Sec. 34 Twp. 17 R. 4 E

Well No. 7 Kaiser

Veeder Supply Company

FIRST REPORT

and Contractor

NW NE NE

ABANDONED

SECTION PLAT

330 Ft. from N. Line

_____ Ft. from S. Line

900 Ft. from E. Line

_____ Ft. from W. Line

			o

Marion County

Location _____

Rig up _____

Drilling and Remarks:

Miss. 2344

2405 TD

5" @ 2351

Water

D & A

RECORD

Cased _____ in., _____ ft.

Sand _____

Gas _____

Oil _____

Total Depth 2405

PRODUCTION

1st 24 hrs. Nat. _____

1st 24 hrs. after shot _____

Gas _____ Cu. Ft.

Dry Hole _____

Abandoned _____

Date

FEB 18 1948 19

S. J. LEWIS Scout