


Section 34 Township 17 Range 4E

Well No. #1 Srajer

Company D. T. Ingling

NORTH

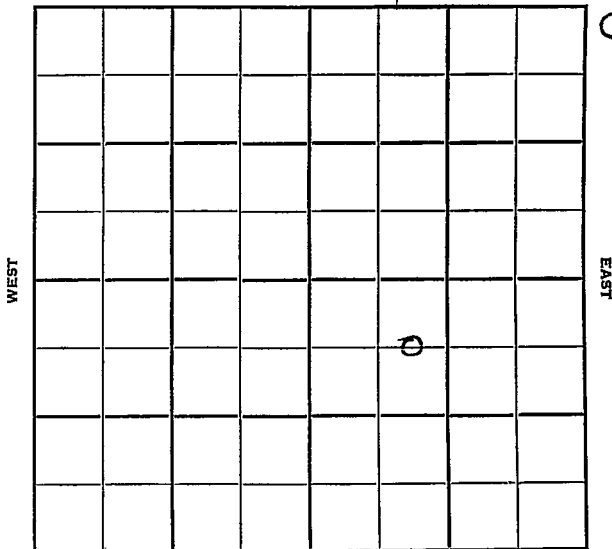

SOUTH

Marion  
17

KANSAS

4E

Sec. 34 Twp. \_\_\_\_\_ R. \_\_\_\_\_

Well No. #1 Srajer Farm \_\_\_\_\_

D. T. Ingling Company \_\_\_\_\_

Lost Springs Pool Contractor \_\_\_\_\_


660' Ft. from N. Line

\_\_\_\_\_ Ft. from S. Line

\_\_\_\_\_ Ft. from E. Line

990' Ft. from W. Line

C E L NW SE

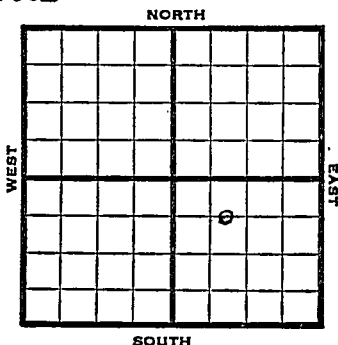

1950 Elev 1460' REPORT

12/27 Drlg.  
 1951  
 1/17 5" @ 2356  
 TD 2403  
 D&A  
**ABANDONED**

County Marion State Kansas

Sec. 34 (Blk. 17 (Sur. 4E) (Twp. 17) Map No.

Operator D. T. Ingling

Well No. 1 Farm Srajer

Elev. \_\_\_\_\_ Location C E L NW SE


660 Ft. From N Line SE

990 Ft. From W Line Quarter

1st. Report DEC 27 1966

Completion \_\_\_\_\_

Remarks \_\_\_\_\_

Spudding Date \_\_\_\_\_

Drig. Data Most Springs Pool

drig.

