

KANSAS

Marion

Section 34 Township 17 Range 4-E

Well No. #2 Srajek

Company Veeder Supply
Lost Spring Pool

NORTH

WEST

EAST

						0	

SOUTH

9

KANSAS.

Marion


Sec. 34 Twp. 17 R. 4EWell No. #2 Srajesk Farm

Veeder Supply Company

Lost Spring Pool

330' Ft. from N. Line Ft. from S. Line990' Ft. from E. Line Ft. from W. Line

NW NE SE

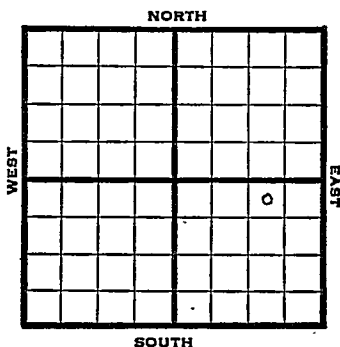

1948

Eli 1463'

REPORT

5/26

RUR

6/1

10" @ 140'
Drlg. 1540'

6/9

No report

6/16

"

6/23

Miss 2246'
7" @ 2246'

6/29

"

7/8

"

7/14

"

7/21

"

7/28

Miss 2346'
7" @ 2346'
TD 2408'
Aband.**ABANDONED**

Map No. _____ Sec. 34 Twp. 17 R. 4E

Well No. 2 Sraiek

Weeder Supply Company

FIRST REPORT Contractor

NW NE SE

SECTION PLAT

330 Ft. from N. Line

_____ Ft. from S. Line

990 Ft. from E. Line

_____ Ft. from W. Line

			6

Marion County

Location _____

Rig up _____

Drilling and Remarks:

R U R

RECORD

Cased _____ in., _____ ft.

Sand _____

Gas _____

Oil _____

Total Depth _____

PRODUCTION

1st 24 hrs. Nat. _____

1st 24 hrs. after shot _____

Gas _____ Cu. Ft.

Dry Hole _____

Abandoned _____

Date

MAY 26 1948 19

S. J. LEWIS Scout

Marion County Kansas State

Map No. 26 Sec. 34 Twp. 17 R. 4E

Well No. 2 Srajek

Weeder Supply Company

ABANDONED

Contractor

E. I. 463

SECTION PLAT

NW NE SE

330 Ft. from N. Line

 Ft. from S. Line

990 Ft. from E. Line

 Ft. from W. Line

						0	

Lost Spring Pool

Remarks:

Miss 2346

7 " @ 2346

YD 2408

Date

JUL 28 1948

Scout

S. J. LEWIS