

Marion

KANSAS

SEC.	TWP.	R.
16	17	4E

WELL NO.

1 Hajek

FARM

COMPANY

Augusta Oil

CONTRACTOR

Co. Tools

Lost Springs Pool

Ft. from N. Line

990'


Ft. from S. Line

660

990'

Ft. from E. Line

Ft. from W. Line

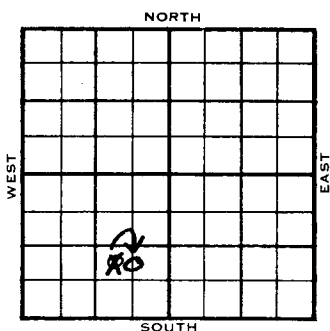~~NW SE SW~~

CN/2 SE SW

1955

ELEVATION

REPORT

5/25

M I R

6/29

Comm 5-24-55

8 5/8", @128/100, 5 1/2" @ 2330/35

DD 2348 FU 550' oil 100' sw 16 hr.

Frac Comp. 50 bopd 15 bw.

Tops: Depth

Datum

M.ch. 2330

890

TD. 2337

COMPLETED

DX-78

DX 78-1


Marion

KANSAS

Section 16 Township 17 Range 4E

Well No. #1 Hajek

Company Augusta Oil

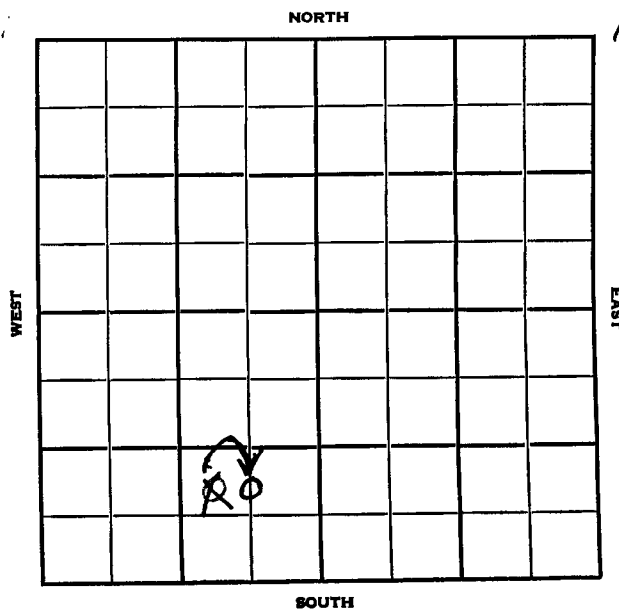

SCOUT TICKET DX-201 Kansas

SEC.	TWP.	R.
16	17	4E

WELL NO.

1 Hajek FARM

COMPANY

Augusta Oil CONTRACTOR

CORRECTION

C N¹/₂ SE SW

FT. FROM N. LINE

990 FT. FROM S. LINE

660 FT. FROM E. LINE

FT. FROM W. LINE

NORTH

WEST

EAST

SOUTH

Marion County

☐ LOCATION ☐ RIG UP DRILLING AND REMARKS: Reported NW SE SW	RECORD	CASED IN., FT.
	PRODUCTION	1ST 24 HRS. NAT.
		1ST 24 HRS. AFTER SHOT
		GAS CU. FT.
		DRY HOLE
		ABANDONED

DATE JUN 1 5 1955

SCOUT L. J. Harris

FORM 275 FOR SALE BY KANSAS BLUE PRINT CO.

County Marion State Kansas

Sec. 16 (Blk. Twp.) 17 (Sur. Rge.) 4E Map No.

Operator Augusta Oil

Well No. 1 Farm Hajek

Elev. Location NW SE SW

990 Ft. From S Line SW

990 Ft. From E Line Quarter

1st. Report MAY 2 5 1955

Completion

Remarks

Co. tools

Spudding Date

Drig. Data

M I R

First Report

FORM 513 REV. SUNRAY

County Marion Elev. 1440

Sec. 16 Twp. 17 Rge. 4E

Company Augusta Oil

FarmName Hajek No. 1

TOPS	DEPTH	LOG	DATUM	Loc. in Sec.
Anh.				C N ¹ / ₂ SE SW
Tr.				
H.				
Tr.				
Dg.				
Bl.				
L.				Geol.
K.C.				
B.K.C.				Contr.
Ce.				
C.				Co. tools
M.	ch	2330	290	
M.				Pool
K.				Lost Springs
Mz.				
Me.				
V.				
S.				
S.				
A.				
R.				
Pe.				
G.				
TD.	2337			

Date Comm. 5-24-55

8 5/8" @ 128/100 5 1/2" @ 2330/35

DD 2348 FU 550' oil 100' sw 16 hr.

frac Comp. 50 bopd 15 bw

JUN 2 9 1955

COMPLETE