

Marion

KANSAS

SEC. 16	TWP. 17	R. 4E
---------	---------	-------

WELL NO. 2
~~#1~~ #2. Hajek FARM

COMPANY
 Augusta Oil

CONTRACTOR
 Co. Tools

Lost Springs


Ft. from N. Line

Ft. from S. Line

Ft. from E. Line

Ft. from W. Line

~~SE~~ SE SW
 C E/2

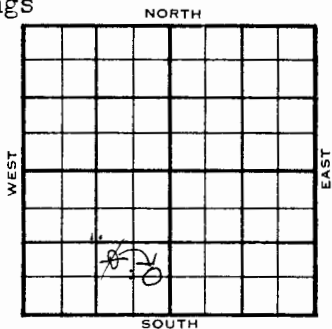

1956

ELEVATION
1430'

REPORT

Hunton test

4-25 Comm. 4-23-56

5-16 8 5/8" @ 115
 4 1/2" @ 2323 w/35

DD 2340'

FU 850' oil

S/ 2 BOPH no/wtr., 4 hrs.

P/ 25 BOPD, no/wtr.

KC. 1748', M. Chat 2322',

TD 2335'

COMPLETED

DX-78


Marion

KANSAS

SECTION 16	TOWNSHIP 17	RANGE 4E
------------	-------------	----------

WELL NO. 2
~~#1~~ #2. Hajek

COMPANY
 Augusta Oil

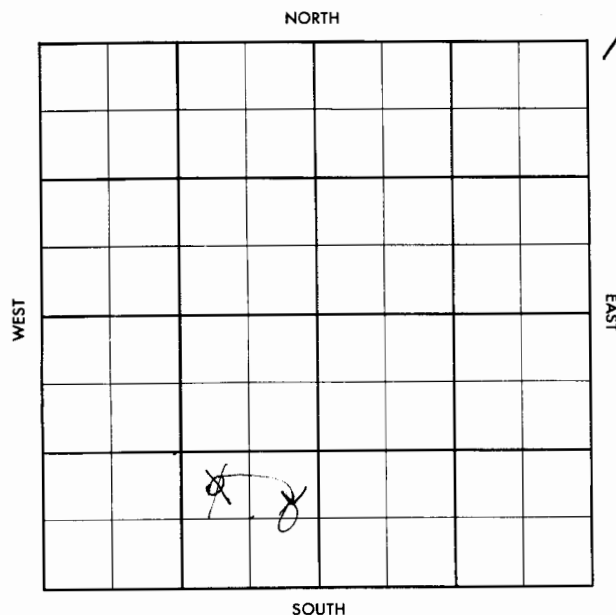

CORRECTION

FORM 513 SUNRAY

County		Marion		Elev.		1430	
Sec.		16		17		Rgs. LE	
Company		Augusta Oil					
FarmName		W. Hajek		No.		22	

TOPS	DEPTH	LOG	DATUM	Loc. in Sec.
Anh.				NW SE SW
TP.				CE/2
H.				
Tr.				Hunton test
Dg.				
BL.				
L.	1748			Geol.
K.C.				Contr.
B.K.C.				Co. tools
Ce.				
C.	chat	2322		Pool
M.				Lost Springs
Nz.				
Me.				
V.				
S.				
A.				
R.				
PE.				
G.				
TD.	2335			

Date Comm. 4-23-56 MAY 2 '56 85/8 115

942 @ 2320 / 35' NW MAY 9 '56 WORT

MAY 16 '56 CO DD 2340 TD FU 850'

oil & 2 BOPH no/w 4 hrs

Per. P. 25 BOPD no/w to

FORM 513 SUNRAY

County		Marion		Elev.			
Sec.		16		17		Rgs. LE	
Company		Augusta Oil					
FarmName		W. Hajek		No.		1	

TOPS	DEPTH	LOG	DATUM	Loc. in Sec.
Anh.				NW SE SW
TP.				
H.				
Tr.				Hunton test
Dg.				
BL.				
L.				Geol.
K.C.				Contr.
B.K.C.				Co. tools
Ce.				
C.				Pool
M.				Lost Springs
Nz.				
Me.				
V.				
S.				
A.				
R.				
PE.				
G.				
TD.				

Date Comm. 4-23-56

10