


SECTION 5 TOWNSHIP 17 RANGE 5E

WELL NO. #1 F.R. Acsell

COMPANY Sooner Oil

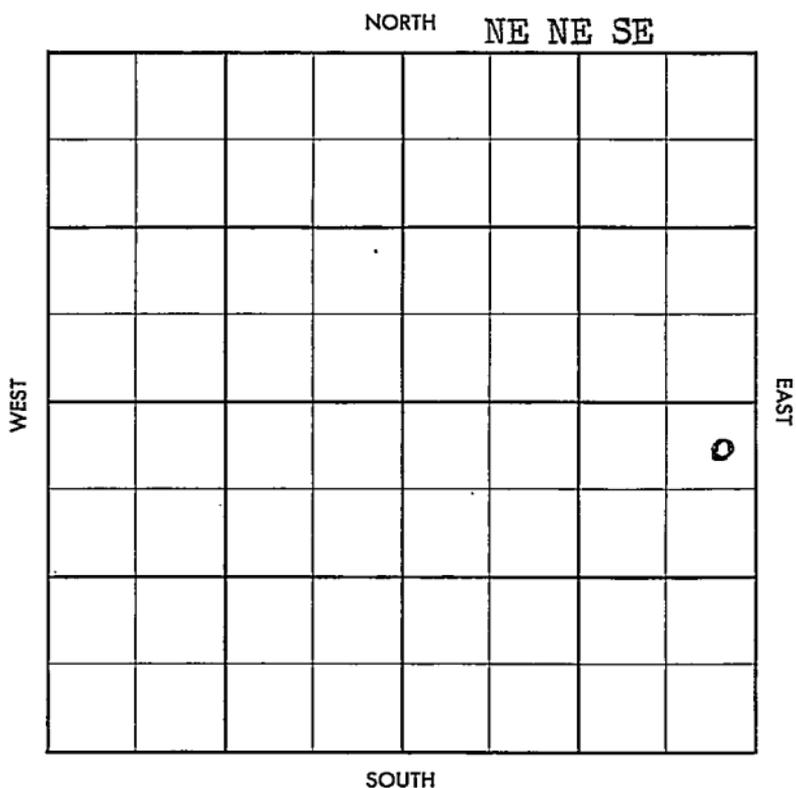

# WILDCAT

(No County Map)

FORM 513 SUNRAY

County Morris Elev. \_\_\_\_\_  
 Sec. 5 Twp. 17 Rgs. 5E  
 Company Sooner Oil  
 Farm Name F. B. Acsell No. 1

TOPS	DEPTH	LOG	DATUM	Loc. in Sec.
Anh.				NE NE SE
TP.				
H.				
Tr.				
Dg.				
Bl.				
L.				Geol. _____
K.C.				Contr. _____
B.K.C.				Slusser Drlg.
Ce.				
C.				Pool _____
M.				Wildcat
M.				
K.				
Mz.				
Ma.				
V.				
S.				
S.				
A.				
R.				
PE.				
G.				
TR.				

JUL 3 '57  
 FIRST REPORT

Date Comm. \_\_\_\_\_  
 Location \_\_\_\_\_

This well comp. on Well  
 MSP Only. W.M.

FORM 513 SUNRAY

(No County Map)

County Morris Elev. 1493 KB  
 Sec. 5 Twp. 17 Rge. 5E  
 Company Sooner Oil  
 Farm Name F. R. Acsell No. 1

TOPS	DEPTH	LOG	DATUM
Anh.			
Tr.			
H.		1589	
Tr.			
Dg.			
Bl.			
L.		1734	
K.C.		1806	
B.K.C. <u>chardite</u>		2870	
Ce. <u>BKC</u>		2878	
C. <u>Macm</u>		2812	
M. <u>CE</u>		2229	
M.		2255	
K.		2290	
Mz. <u>Hunt Li</u>		2443	
Mo. <u>" Dols</u>		2449	
V.			
S.			
S.			
A.			
R.			
PE. <u>2443/14</u>			
G.			
T.D.		2494	

Loc. in Sec. NE NE SE  
 Geol. \_\_\_\_\_  
 Contr. \_\_\_\_\_  
 Slusser Drlg  
 Pool Wildcat  
 ABANDONED  
 JUL 24 '57

Date Comm.

Location JUL 10 '57 X WOR JUL 17 '57

7-15-57 Ø 86 JUL 24 '57 85E

1961100

DEB

255  
2078  
171

2078  
1995  
545