

KANSAS


FORM 51 5M PETROL

Marion

Section 6 Township 17 Range 1-E

Well No. #1 Fanske (Fanska)

Company Nelson Drlg.

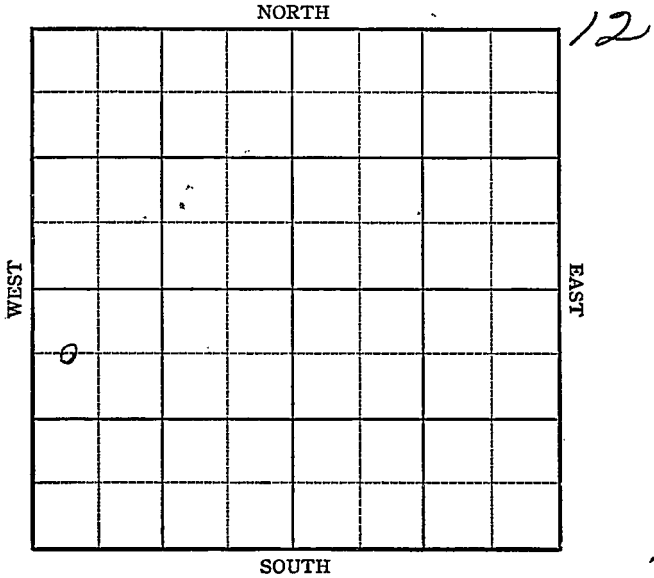

Sec. 6 Twp. 17 R. 1-E

Well No. #1 Fanske Farm

Nelson Drlg. Company


660 Ft. from N. Line

_____ Ft. from S. Line

_____ Ft. from E. Line

330 Ft. from W. Line

Elev. 1375

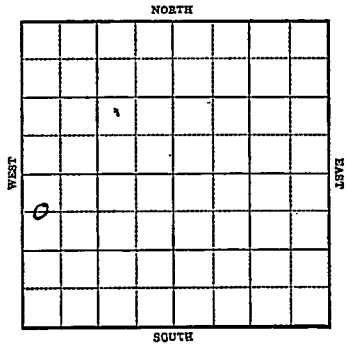

1943

R E P O R T

10/27 Drlg. 1200'

11/3 Lans 2060

Miss 2672

5" @ 2672

R.D. 2677

Rust

SD

11/10 T.D. 2683

Pump 50 oil in 6 hrs.

11/17 " " "

12-1 5" @ 2672

Miss 2672

TD 2683

Pump 200 Pot.

Gravity 37.4

COMPLETED

Map No. KANSAS Sec. 6 Twp. 17 R. 1E

Well No. 1 Fanska

Nelson Drlg. Company

FIRST REPORT Contractor

C W L NW SW

660 Ft. from N. Line

_____ Ft. from S. Line

_____ Ft. from E. Line

330 Ft. from W. Line

SECTION PLAT

0			

Wildcat

Location _____

Rig up _____

Drilling and Remarks:

1200'

RECORD

Cased _____ in., _____ ft.

Sand _____

Gas _____

Oil _____

Total Depth _____

PRODUCTION

1st 24 hrs. Nat. _____

1st 24 hrs. after shot _____

Gas _____ Cu. Ft.

Dry Hole _____

Abandoned _____

Date

OCT 27 1943

19

S. J. LEWIS Scout

Map No. KA 13 Sec. 6 Twp. 17 R. 1E

Well No. 1 Fanska

Nelson Drig. Company

COMPLETED Contractor

C W L NW SW

SECTION PLAT

660 Ft. from N. Line

_____ Ft. from S. Line

_____ Ft. from E. Line

330 Ft. from W. Line

o			

Wildcat

Location _____

Rig up _____

Drilling and Remarks:

Miss 2672

5" C 2672

Pump 200 ft

37 ft

RECORD

Cased _____ in., _____ ft.

Sand _____

Gas _____

Oil _____

Total Depth 2688

PRODUCTION

1st 24 hrs. Nat. _____

1st 24 hrs. after shot _____

Gas _____ Cu. Ft.

Dry Hole _____

Abandoned _____

Date

DEC 1 1943 19

S. J. LEWIS Scout