

Section 6 Township 17 Range 1E

Well No. #1 Law

Company Westgate-Greenland et al

NORTH

5

e							

SOUTH

WEST

EAST

Marion

KANSAS

Sec. 6 Twp. 17 R. 1E

Well No. #1 Law Farm

Westgate-Greenland etal. Company

Fanska


 Ft. from N. Line

660 Ft. from S. Line

 Ft. from E. Line

330 Ft. from W. Line

Elev. 1376

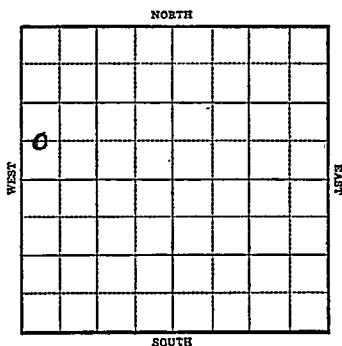

1944

R E P O R T

2/23 8" @ 130' / ?
Drilling 250'

3/1 Drlg. 2355'

3/8 Lans 2060
Miss 2690
SD
TD 2693
5" @ 2690
Rust

3/16 "

3/22 "

3/29 5" @ 2690
Miss 2690
Td 2709
Bump 153 Pot.
Gravity 36.9

COMPLETED

KANSAS


Map No. 25 Sec. 6 Twp. 17 R. 1EWell No. 1 LawWestgate-Greenland et al. Company

FIRST REPORT

Contractor

C W L SW NW

SECTION PLAT

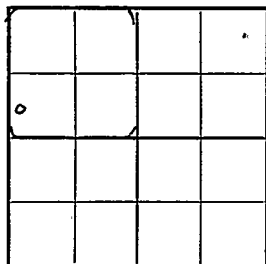

Ft. from N. Line

660

Ft. from S. Line

Ft. from E. Line

330

Ft. from W. Line

Fanska Pool

Location _____

Rig up _____

Drilling and Remarks:

8" - 130 250

RECORD

Cased _____ in., _____ ft.

Sand _____

Gas _____

Oil _____

Total Depth _____

PRODUCTION

1st 24 hrs. Nat. _____

1st 24 hrs. after shot _____

Gas _____ Cu. Ft.

Dry Hole _____

Abandoned _____

Date

FEB 23 1944 19

S. L. LEWIS

Scout

KANSAS
 Map No. 25 Sec. 6 Twp. 17 R. 1E

Well No. 1 Law

Westgate-Greenland et al. Company

COMPLETED

Contractor

C W L SW NW

SECTION PLAT

 Ft. from N. Line

660 Ft. from S. Line

 Ft. from E. Line

330 Ft. from W. Line

Fanska Pool

Location

Rig up

Drilling and Remarks:

Miss 2690

5" C 2690

Pump. 153

362

RECORD

Cased in., ft.

Sand

Gas

Oil

Total Depth 2209

PRODUCTION

1st 24 hrs. Nat:

1st 24 hrs. after shot

Gas Cu. Ft.

Dry Hole

Abandoned

Date

MAR 29 1944 19

S. J. LEWIS Scout