

Marion


FORM 51

KANSAS

Section 8 Township 17 Range 1E

Well No. #1 Schneider

Company Geo. Marilatt

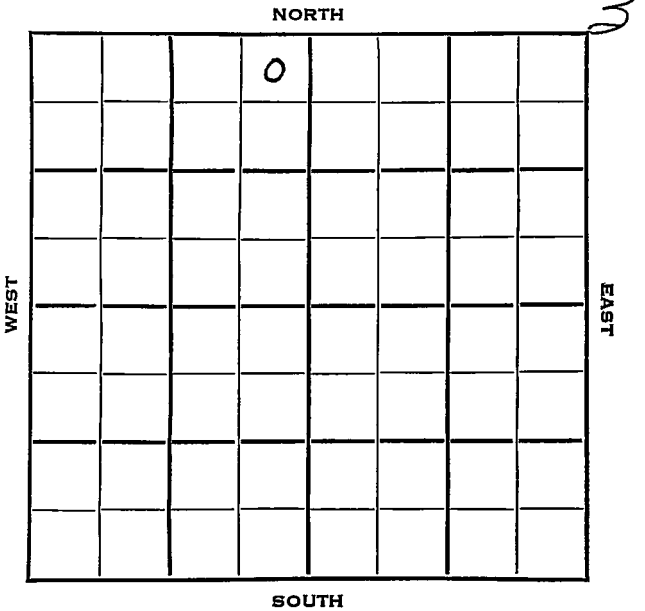


Marion		KANSAS ✓
SEC. 8	TWP. 17	R. 4E
WELL NO. #1 #2 Schneider FARM		
COMPANY Slusser Drig. GEO. MARILATT		
CONTRACTOR Slusser Drig.		

330 _____ Ft. from N. Line

_____ Ft. from S. Line

330 _____ Ft. from E. Line

_____ Ft. from W. Line

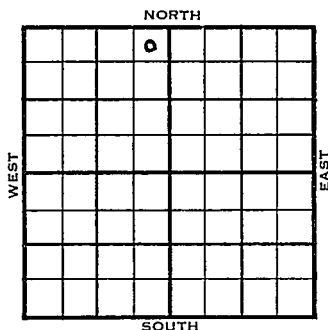

NE NE NW

1953	ELEVATION	REPORT
	1392'	

11/4 M I R

11/24 Spud 11-4-53
 D & A
 TD 2389'
 8" @ 107'
 Miss 2339',
 TD 2340'
 5" @ 2340'
 DD 2389 HFW
 D & A

ABANDONED

County Marion State Kansas

Sec. 8 (Blk. Twp.) 17 (Sur. Rge.) 4E Map No.

Operator **Slusser Drlg.**

Well No. **2** Farm **Schneider**

Elev.	Location	NE	NE	NW
-------	----------	----	----	----

FIRST REPORT

330 Ft. From N Line NW

330 Ft. From H Line Quarter

1st. Report NOV 4 1953

Completion

Remarks

Slusser Drig. - Contr.

Spudding Date

Drlg. Data

M I R

Kansas

Map No. _____ Sec. 8 Twp. 17 R. 4EWell No. 1 Schneider

Geo. Marilatt

Company

CORRECTION

Contractor

NE NE NW

SECTION PLAT

330 Ft. from N. Line

_____ Ft. from S. Line

330 Ft. from E. Line

_____ Ft. from W. Line

		0	

Marion County

Location _____

Rig up _____

Drilling and Remarks:

Reported

#2 Schneider

Slusser Drlg.

RECORD

Cased _____ in., _____ ft.

Sand _____

Gas _____

Oil _____

Total Depth _____

PRODUCTION

1st 24 hrs. Nat. _____

1st 24 hrs. after shot _____

Gas _____ Cu. Ft.

Dry Hole _____

Abandoned _____

Date

NOV 11 1953J. G. MCGEHEE

Scout

County Marion State Kansas

Sec. 8 (Blk. Twp.) 17 (Sur. Rge.) 4E Map No.

Operator Geo. Marilatt

Well No. 1 Farm Schneider

Elev. 1392 Location NE NE NW

0

ABANDONED

330 Ft. From N Line NW

330 Ft. From E Line Quarter

1st. Report

Completion NOV 24 1953

Remarks

Slusser Drlg. - Contr.

Spudding Date 11-4-53

Drig. Data D & A TD 2389

8" @ 107 Miss. 2339 TD 2340

5" @ 2340 DD 2389 HFW

D & A

J. G. McGEHEE