

KANSAS


FORM 51 5M 1-42 PETROL

Marion

Section 9 Township 17 Range 4-E

Well No #2 Deines

Company Nelson Drlg. etal

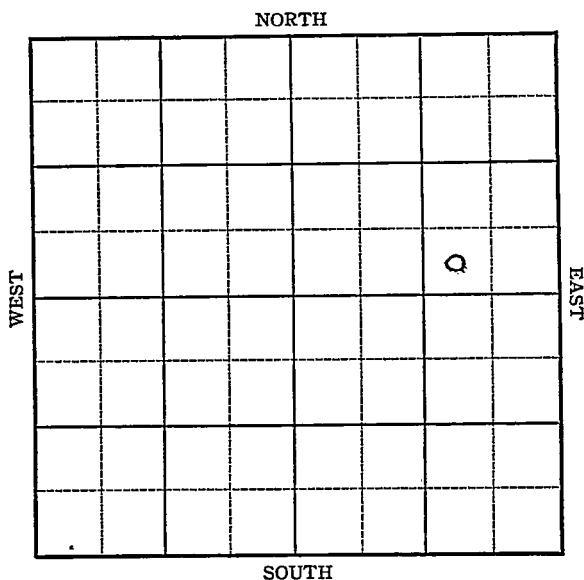

ISA


Marion

Sec. 9 Twp. 17 R. 4-E

Well No. #2 Deines Farm

Nelson Drlg. etal Company

NORTH

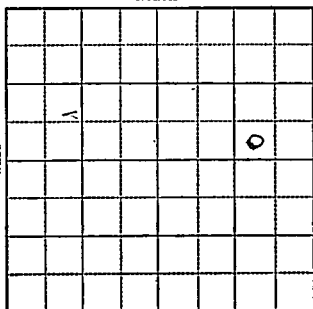

 Ft. from N. Line

330 Ft. from S. Line

990 Ft. from E. Line

 Ft. from W. Line

E. L. 11. 1420

SOUTH

1943

REPORT

11/24
12-1

Surface hole
Chat 2342
TD 2377

COMPLETED

KANSAS

Map No. 26 Sec. 9 Twp. 17 R. 4EWell No. 2 DeinesNelson Drlg. et al. Company

FIRST REPORT

Contractor

SW SE NE

SECTION PLAT

Ft. from N. Line

330

Ft. from S. Line

990

Ft. from E. Line

Ft. from W. Line

Lost Spring Pool

Location

Rig up

Drilling and Remarks:

Surface Hole

RECORD

Cased _____ in., _____ ft.

Sand _____

Gas _____

Oil _____

Total Depth _____

PRODUCTION

1st 24 hrs. Nat. _____

1st 24 hrs. after shot _____

Gas _____ Cu. Ft.

Dry Hole _____

Abandoned _____

Date

NOV 24 1943 19

S. J. LEWIS Scout

Map No. KANSAS 26 Sec. 9 Twp. 17 R. 4E

Well No. 2 Deines

Nelson Drlg. etal. Company

COMPLETED Contractor

SW SE NE

SECTION PLAT

			0

 Ft. from N. Line

330 Ft. from S. Line

990 Ft. from E. Line

 Ft. from W. Line

Lost Spring Pool

Location

Rig up

Drilling and Remarks:

Chas 2342

RECORD

Cased in., ft.

Sand

Gas

Oil

Total Depth 2377

PRODUCTION

1st 24 hrs. Nat.

1st 24 hrs. after shot

Gas Cu. Ft.

Dry Hole

Abandoned

Date

DEC 1 1943 19

S. J. LEWIS Scout