

KANSAS DRILLERS LOG

K C S LIBRARY

S. 19 T. 18 R. 1 E
Loc. C NW SE
County Marion

API No. 15 — County _____ Number _____

Operator
Pickrell Drilling Co.

Address
205 Litwin Building, Wichita, Kansas


Well No. 1 Lease Name Donahue "A"

Footage Location
1980 feet from ~~XX~~ (S) line 1980 feet from (E) (W) line

Principal Contractor Kan-Go, Inc. Geologist _____

Spud Date 4-7-77 Total Depth 3450 P.B.T.D. _____

Date Completed 4-13-77 Oil Purchaser P & A

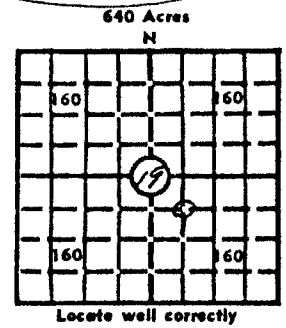

Elev.: Gr. _____
DF _____ KB _____

CASING RECORD

Report of all strings set — surface, intermediate, production, etc.

Purpose of string	Size hole drilled	Size casing set (in O.D.)	Weight lbs/ft.	Setting depth	Type cement	Sacks	Type and percent additives
Surface	12 1/4"	8-5/8"		210 K.B.	Class A	150	4% CaCl

LINER RECORD

PERFORATION RECORD

Top, ft.	Bottom, ft.	Sacks cement	Shots per ft.	Size & type	Depth interval

Size	Setting depth	Packer set at

ACID, FRACTURE, SHOT, CEMENT SQUEEZE RECORD

Amount and kind of material used	Depth interval treated

INITIAL PRODUCTION

Date of first production _____ Producing method (flowing, pumping, gas lift, etc.) _____

RATE OF PRODUCTION PER 24 HOURS	Oil	Gas	Water	Gas-oil ratio
	bbls.	MCF	bbls.	CFPB

Disposition of gas (vented, used on lease or sold) _____ Producing interval(s) P & A

INSTRUCTIONS: As provided in KCC Rule 82-2-125, within 90 days after completion of a well, one completed copy of this Drillers Log shall be transmitted to the State Geological Survey of Kansas, 4150 Monroe Street, Wichita, Kansas 67209. Copies of this form are available from the Conservation Division, State Corporation Commission, 3830 So. Meridian (P.O. Box 17027), Wichita, Kansas 66217. Phone AC 316-522-2206. If confidential custody is desired, please note Rule 82-2-125. Drillers Logs will be on open file in the Oil and Gas Division, State Geological Survey of Kansas, Lawrence, Kansas 66044.

Pickrell Drilling Co.

DESIGNATE TYPE OF COMP.: OIL, GAS,
DRY HOLE, SWDW, ETC.:

Well No.

1

Lease Name

Donahue "A"

19-18-1E

S 19 T 18 R 1 E
XX

WELL LOG

Show all important zones of porosity and contents thereof; cored intervals, and all drill-stem tests, including depth interval tested, cushion used, time tool open, flowing and shut-in pressures, and recoveries.

SHOW GEOLOGICAL MARKERS, LOGS RUN,
OR OTHER DESCRIPTIVE INFORMATION.

FORMATION DESCRIPTION, CONTENTS, ETC.	TOP	BOTTOM	NAME	DEPTH
Lansing	2211			
Mississippi Chat	2791			
Mississippi Lime	2864			
Kinderhook Shale	3000			
Hunton	3167			
Maquoketa Shale	3173			
Viola	3261			
Simpson	3356			
Arbuckle	3422			

USE ADDITIONAL SHEETS, IF NECESSARY, TO COMPLETE WELL RECORD.

Date Received

Frank A. Sayer
Signature

GEOLOGIST

9-27-27