


marion

Map No. _____ Sec. 1 Twp. 18 R. 4 EWell No. 1-Hartke FarmPrairie Oil & Gas Company

NORTH

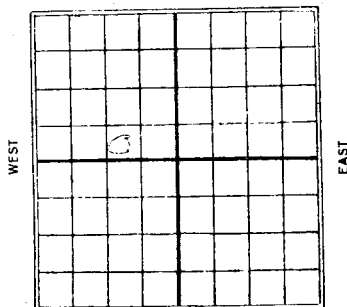

_____ Ft. from N. Line

330 Ft. from S. Line990 Ft. from E. Line

_____ Ft. from W. Line

SOUTH

1927

Date

REPORT

9/14	Location
9/19	Spudding
10/6	Drlg 800
10/12	" 1420
10/19	" 1875
10/27	" 2140 Crooked hole
11/2	Chat 2294-2340
	Sile. line 2520-2521
	H.F.W. - S.D.
11/9	Fighting Cave @ 2520-
11/16	Drilling 2647-
11/23	W.R. 5"-2660
11/30	—
12/7	Drlg 2675'
12/14	Chat 2294-2340
	sile. line 2520-2521
	H.F.W. Drlg 2730
12/21	H.F.W. from 2788-2805-
	S.D. for orders.
12/29	Chat 2294-2340
	Sile. line 2520-21-H.F.W.
	H.F.W. 2788-2805

1-0 9805

No. *11959* **KANSAS** *Nation* *E*
 Map No. _____ Sec. *1* Twp. *18* R. *4*
 Well No. *1* *Hartke*
Prairie Oil & Gas Co. Company

Contractor _____

FIRST REPORTS

SECTION PLAT

_____ Ft. from N. Line

330

_____ Ft. from S. Line

990 _____ Ft. from E. Line

_____ Ft. from W. Line

Location ☒ _____

Rig up _____

Drilling and Remarks:

RECORD

Cased _____ in., _____ ft.

Sand _____

Gas _____

Oil _____

Total Depth _____

PRODUCTION

1st 24 hrs. Nat. _____

1st 24 hrs. after shot _____

Gas _____ Cu. Ft.

Dry Hole _____

Abandoned _____

Date

SEP 14 1927

CHAS. L. SHERWOOD

192

Scout

no trace
KANSASMap No. _____ Sec. 1 Twp. 18 R. 4Well No. 1 NorthPrairie Oil & Gas Co. Company_____
Contractor

COMPLETED

Ft. from N. Line330 Ft. from S. Line990 Ft. from E. Line_____
Ft. from W. Line

ABANDONED

SECTION PLAT

Location _____

Rig up _____

Drilling and Remarks:

Shot 2294-2340Sile line 2520-21AFW 2788-28052944 2805

RECORD

Cased _____ in., _____ ft.

Sand _____

Gas _____

Oil _____

Total Depth 2805

AFW PRODUCTION

1st 24 hrs. Nat. _____

1st 24 hrs. after shot _____

Gas _____ Cu. Ft.

Dry Hole ☒Abandoned ☒

Date

EC 29 1927

CHAS. L. SHERWOOD

102

Scout

MAP No. _____ SEC. 1 TWP. 18S R. 4EWELL No. 1 Hunter_____Prinice COMPANY_____no wall map CONTRACTOR

SECTION PLAT

	0		

_____0 Ft. FROM N. LINE_____0 Ft. FROM S. LINE_____0 Ft. FROM E. LINE_____0 Ft. FROM W. LINE

LOCATION _____

RIG UP _____

DRILLING AND REMARKS:

RECORD

CASED _____ IN. _____ FT.

SAND _____

GAS _____

OIL _____

TOTAL DEPTH 2805

PRODUCTION

1ST 24 HRS. NAT. _____

1ST 24 HRS. AFTER SHOT _____

GAS _____ CU. FT.

DRY HOLE ✓ABANDONED ✓

DATE

12/28 1927 _____ SCOUT