


Section 10 Township 18 Range 4 E

Well No. #1 Podszus

Company Harvey Elton

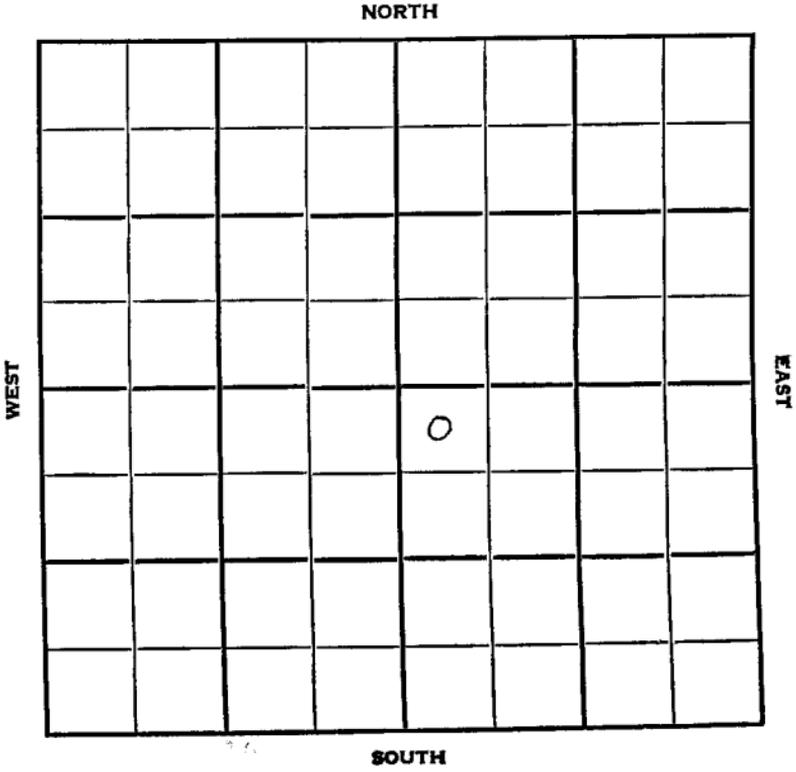

Marion

KANSAS

SEC. 10	TWP. 18	R. 4E
------------	------------	----------

WELL NO.

#1 Podszus

FARM

COMPANY

Harvey Elton

CONTRACTOR

Berentz

SE Lost Springs


_____ Ft. from N. Line

_____ Ft. from S. Line

_____ Ft. from E. Line

_____ Ft. from W. Line

NW NW SE

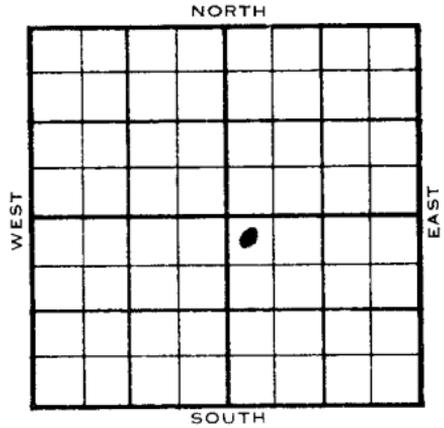

	ELEVATION	REPORT
1955	1417'	
8/3	MIR	FIRST REPORT
9-7	8 5/8" @ 160 4 1/2" @ 2340 DD 2373 SSO & Wtr. PB 2360 frac Comp. 25 bopd 50% wtr. Tops: M. 2340 T.D. 2342'	COMPLETED

County **Marion** Elev. _____
 Sec. **10** Twp. **18** Rge. **4E**
 Company **Harvey Elton**
 Farm Name **Podzus** No. **1**

TOPS	DEPTH	LOG	DATUM	Loc. in Sec.
Anh.				NW NW SE
Tr.				
Dg.				
Bl.				
L.				Geol. _____
K.C.				Contr. _____
B.K.C.				
Ce.				Berents
C.				Pool _____
M.				
M.				
K.				SE Lost Springs
Mz.				
Me.				
V.				
S.				
S.				
A.				
R.				
PE.				
G.				
T.D.				

FIRST REPORT
 D
 AUG 3 55

Date Comm. **M I R**

Co.
Lse.
No.
Sec.
I.
n.

County Marion Elev. 1117
 Sec. 10 Twp. 18 Rge. 4E
 Company Harvey Elton
 Farm Name Podszus No. 1

TOPS	DEPTH	LOG	DATUM	Loc. in Sec.
Anh.				NW NW SE
Tp.				
H.				
Tr.				
Dg.				
Bl.				
L.				Geol.
K.C.				Contr.
B.K.C.				<u>Berentz</u>
Ce.				Pool
C.	<u>2340</u>		<u>92.3</u>	<u>SE Lost Spring</u>
M.				
M.				
K.				
Mz.				
Ma.				
V.				
S.				
S.				
A.				
R.				
Pe.				
G.				
T.D.	<u>2340</u>			

Date Comm. 8-2-55 SEP 7 1955

8 5/8" @ 160 4 1/2" @ 2340 DD 2373

SSO & Wtr. PB 2360 frac

Comp. 25 bopd 50% wtr.