

Lyons

KANSAS

SECTION 10 TOWNSHIP 18 RANGE 10 F

WELL NO. #1 Downing

COMPANY Wixson Drlg. et al

NORTH

WEST

EAST

	0						

SOUTH

4

Lyon

KANSAS

SEC.	TWP.	R.
10	18	10E

WELL NO.

#1 Downing

FARM

COMPANY

Wixson Drlg. etal

CONTRACTOR

WILDCAT


Ft. from N. Line

Ft. from S. Line

Ft. from E. Line

Ft. from W. Line

NE NW NW

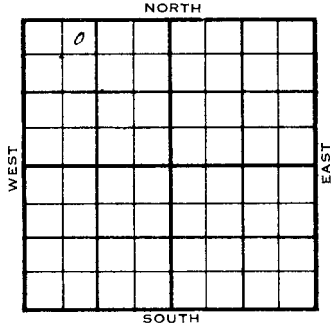

Shell - DHM

1955

ELEVATION

REPORT

11-30

MICT

County Lyon Elev. 10E
 Sec. 10 Twp. 18 Rge. 10E
 Company Wixson Drig. etal.
 Farm Name Downing No. 1


TOPS	DEPTH	LOG	DATUM
Anb.			
TP.			
H.			
Tr.			
Dg.			
BL.			
L.			
K.C.			
B.K.C.			
Ce.			
C.			
M.			
M.			
K.			
Mz.			
Mo.			
V.			
S.			
S.			
A.			
R.			
PE.			
G.			
TD.			

Loc. in Sec. NE NW NW

Geol. _____

Contr. _____

Pool

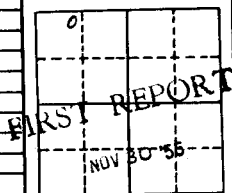Wildcat

Date Comm. _____

Shell - DHM**MICT**

No County Map


TOPS	DEPTH	LOG	DATUM	Loc. in Sec.
Anh.				
Tr.				
H.				
Tr.				
Dg.				
BL.				
L.	<u>1195</u>		<u>45</u>	
K.C.	<u>1322</u>		<u>172</u>	Geol.
B.K.C.	<u>1400</u>		<u>450</u>	
Co. <u>Martin</u>	<u>1705</u>		<u>555</u>	Conte.
G. <u>44</u>	<u>1860</u>		<u>710</u>	
M. <u>41</u>	<u>2220</u>		<u>1580</u>	
M.				Pool
K.	<u>2580</u>		<u>1430</u>	
No.	<u>2727</u>		<u>1557</u>	W. Test
No. <u>HUNT</u>	<u>2707 1/2</u>			
V.	<u>2720</u>		<u>1630</u>	
S.	<u>2838</u>		<u>1682</u>	
S. <u>sd</u>	<u>2848</u>		<u>1690</u>	
A.	<u>2912</u>		<u>1762</u>	
R.				
PE.				
G.				
TR.	<u>2940</u>			

FEB 15 1956

ABANDONED

Date Comm.

Shell - 10'

11:00 AM DEC 7 '55 ✓ DEC 14 '55 RUP DEC 15 '55

12-17-55 15 1/2" 45 120

DEC 28 '55 795 JAN 5 '56 10" 1580

10 ahead. JAN 11 '56 2" 2246 10

2275 JAN 18 '56 7" 2580 JAN 25 '56

5' 12" 2818 FEB 1 '56 20 FEB 8 '56 ✓

FEB 15 '56 Hole Full water 2940

2230
1150
1080