

Map No. Konsas Sec. 11 Twp. 18 R. 42

Well No. 1 Ridenour Farm

Apell et al Company

NORTH

WEST

EAST

SOUTH

Location _____

Drilling Remarks

Rig Up_____

Drilling Remarks

RECORD

Cased_____in. _____ft.

Sand

Gas _____

Oil _____

Total Depth -----

PRODUCTION

1st 24 hrs. Nat.-----

1st 24 hrs. after shot -----

Gas_____cu. ft.

Dry Hole-----

Abandoned _____

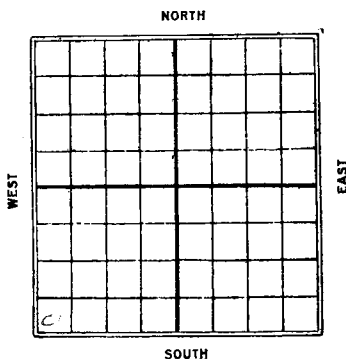
Lyon Co

Map No. Kansas Sec. 11 Twp. 18 R 12Well No. 1 Ridenover FarmAbell et al Company

Ft. from N. Line

250 Ft. from S. Line

Ft. from E. Line

250 Ft. from W. Line

Date

REPORT

<u>1/26</u>	
<u>1/30</u>	<u>Location</u>
<u>1/27</u>	<u> </u>
<u>2/4</u>	<u> </u>
<u>2/10</u>	<u> </u>
<u>2/17</u>	<u> </u>
<u>2/24</u>	<u> </u>
<u>3/5</u>	<u> </u>
<u>3/10</u>	<u> </u>
<u>3/18</u>	<u> </u>
<u>3/25</u>	<u> </u>
<u>4/1</u>	<u> </u>
<u>4/7</u>	<u> </u>
<u>4/15</u>	<u> </u>
<u>4/21</u>	<u> </u>
<u>4/28</u>	<u>machine</u>
<u>5/8</u>	<u>Spudding</u>
<u>5/14</u>	<u>Dr 400'</u>
<u>5/19</u>	<u>" 1230'</u>
<u>6/2</u>	<u>sample</u>
<u>6/10</u>	<u>Dr 1400</u>
<u>6/18</u>	<u>" 1900 no sand</u>

6/24- Abandoned 2030

Norman ⁶⁵ KANSAS Sec. 11 Twp. 18 R. 12
 Map No. _____
 Well No. 1 *Ridenour*
Adell of Ad Company

Contractor

FIRST REPORTS

_____ Ft. from N. Line

250 _____ Ft. from S. Line

_____ Ft. from E. Line

250 _____ Ft. from W. Line

SECTION PLAT

0			

Location ☒ _____

Rig up _____

Drilling and Remarks:

RECORD

Cased _____ in., _____ ft.

Sand _____

Gas _____

Oil _____

Total Depth _____

PRODUCTION

1st 24 hrs. Nat. _____

1st 24 hrs. after shot _____

Gas _____ Cu. Ft.

Dry Hole _____

Abandoned _____

Date _____

JAN 20 1926

CHAS. L. SHERWOOD

192

Scout

no map
 Map No. **KANSAS** Sec. **11** Twp. **18** R. **12**

Well No. **1** **SHERWOOD**
ebao & et 4h Company

Contractor

COMPLETED

SECTION PLAT

0			

Ft. from N. Line

250

Ft. from S. Line

Ft. from E. Line

250

Ft. from W. Line

ABANDONED

Location

Rig up

Drilling and Remarks:

missed sand

top line 2018

D.R.

2020

RECORD

Cased _____ in., _____ ft.

Sand _____

Gas _____

Oil _____

Total Depth **2020**

PRODUCTION

1st 24 hrs. Nat. _____

1st 24 hrs. after shot _____

Gas _____ Cu. Ft.

Dry Hole ☒Abandoned ☒

Date

JUN 24 1926

CHAS. L. SHERWOOD

192

Scout