


Marion

KANSAS

SECTION 12 TOWNSHIP 18 RANGE 4E

WELL NO. #1 Kaiser

COMPANY Augusta Oil Co.

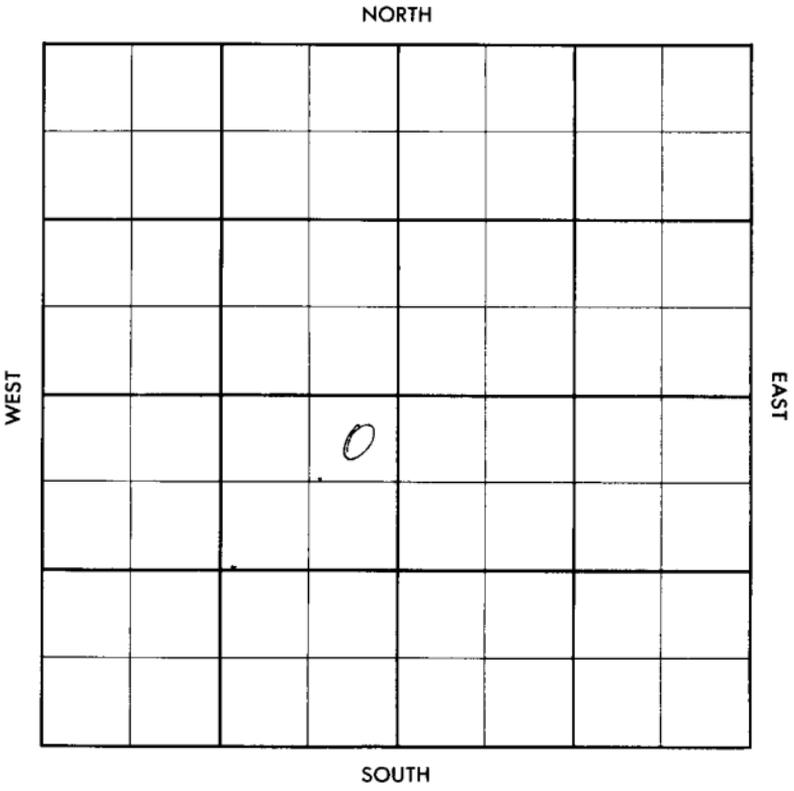

 Sec. 12 Twp. 18S Rge. 4E
 Company Augusta Oil Co.
 Farm Name Kaiser No. 1

TOPS	DEPTH	LOG	DATUM	Loc. in Sec.
Anh.				NE NE SW
Tr.				DS - SW
H.				& S ¹ / ₂ SE ¹ / ₂
Tr.				
Dg.				
Bl.				
L.				Geol. _____
K.C.				Contr. _____
B.K.C.				
Ce.				Co. _____
C.				
M.				
M.				
K.				
Nz.				
Me.				
V.				
S.				
S.				
A.				
R.				
Pe.				
G.				
TD				

Geol. _____
 Contr. _____
 Co. _____

PSAT

Wildecat

FIRST REPORT

0		
00	3	56

Date Comm. MTBT

