


Lyons
KANSAS ✓

Section 13 Township 18 Range 10E

Well Number 1 Bruce

Company Clyde Fred et al

4

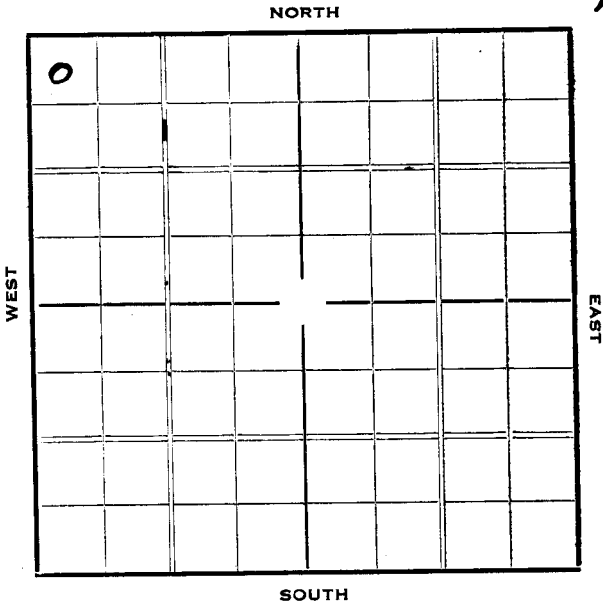

KANSAS

Map No. 28 Sec. 13 Twp. 18 R. 10EWell No. 1 BruceCycle Fred & Co Company Contractor

SECTION PLAT

0			

330 Ft. from N. Line Ft. from S. Line Ft. from E. Line330 Ft. from W. Line

FIRST REPORT

Location Rig up

Drilling and Remarks:

Mac h

RECORD

Cased in., ft.Sand Gas Oil Total Depth

PRODUCTION

1st 24 hrs. Nat. 1st 24 hrs. after shot Gas Cu. Ft.Dry Hole Abandoned

Date

NOV 16 1936

19

S. J. LEWIS

Scout

KANSAS

Map No. 28 Sec. 18 Twp. 18 R. 10E

Well No. 1 Bruce

Clyde Fred & Co. Company
Contractor

SECTION PLAT

830 Ft. from N. Line
____ Ft. from S. Line
____ Ft. from E. Line
830 Ft. from W. Line

0			

ABANDONED

Location _____

Rig up _____

Drilling and Remarks:

DDH

RECORD

Cased _____ in., _____ ft.
Sand _____
Gas _____
Oil _____
Total Depth 2291

PRODUCTION

1st 24 hrs. Nat. _____
1st 24 hrs. after shot _____
Gas _____ Cu. Ft.
Dry Hole _____
Abandoned _____

Date

JAN 26 1937