

SECTION 15 TOWNSHIP 18 RANGE 4E

WELL NO. #1 Anton Stika


COMPANY Frank Dieter

NORTH

C N/2
NW SW SW

WEST

EAST

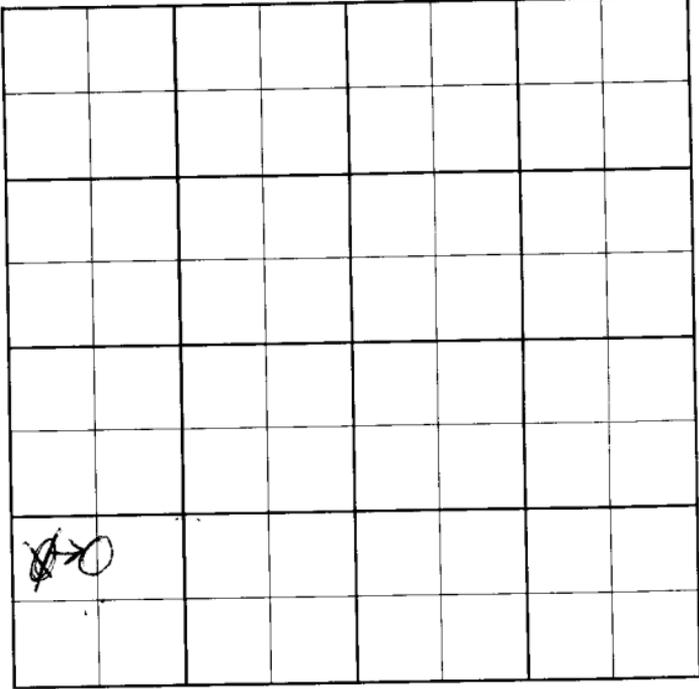

SOUTH

County **Marion** Elev. _____
 Sec. **15** Twp. **18** Rge. **4E**
 Company **Frank Dieter**
 Farm Name **Anton Stika** No. **1**

TOPS	DEPTH	LOG	DATUM	Loc. in Sec.
Anh				NW SW SW
Tr.				
H.				
Tr.				
Dg.				
Bl.				
L.				Geol. _____
K.C.				Contr. _____
B.K.C.				
Ce.				Slusser Tools
C.				
M.				Pool _____
M.				
K.				Lost Springs SE
Mz.				
Me.				
V.				
S.				FIRST REPORT
S.				
A.				
R.				
PE.				
G.				
TD.				

MAY 29 '57

Date Comm.

W O R T

~~NO~~

Co.

6

No.

Sec.

T.

n.

