

16-1P-196 Ind. P1

TYPE

AFFIDAVIT OF COMPLETION FORM

ACO-1 WELL HISTORY

Compt. \_\_\_\_\_

SIDE ONE

(Rules 82-3-130 and 82-3-107)

DOCKET NO. NP \_\_\_\_\_

This form shall be filed with the Kansas Corporation Commission, 200 Colorado Derby Building, Wichita, Kansas 67202, within ninety (90) days after the completion of a well, regardless of how the well was completed.

FOR INFORMATION REGARDING THE NUMBER OF COPIES TO BE FILED AND APPLICATIONS REQUIRING COPIES OF ACO-1 FORMS SEE PAGE TWO (2), SIDE TWO (2) OF THIS FORM.

F \_\_\_\_\_ Letter requesting confidentiality attached.

C  Attach ONE COPY of EACH wireline log run (i.e. electrical log, sonic log, gamma ray neutron log etc.)\*\*\*Check here if NO logs were run \_\_\_\_\_.

PLEASE FILL IN ALL INFORMATION. IF NOT AVAILABLE, INDICATE. IF INFORMATION LATER BECOMES AVAILABLE, SUBMIT BY LETTER.

LICENSE # 5913 EXPIRATION DATE June Yearly

OPERATOR Alco Drilling Company, Inc. API NO. 15-052-23,408

ADDRESS R.R. 3 COUNTY Franklin

Iola, Kansas 66749 FIELD \_\_\_\_\_

\*\* CONTACT PERSON T. G. Wright PROD. FORMATION \_\_\_\_\_

PHONE 316-263-1481 \_\_\_\_\_ Indicate if new pay.

PURCHASER \_\_\_\_\_ LEASE Rubick

ADDRESS \_\_\_\_\_ WELL NO. 1

DRILLING Alco Drilling Company, Inc. 330 Ft. from S Line and

CONTRACTOR ADDRESS R.R. 3 330 Ft. from W Line of

Iola, Kansas 66749 the SE (Qtr.) SEC 16 TWP 18 RGE 18 (E) (W).

PLUGGING Alco Drilling Company, Inc. WELL PLAT \_\_\_\_\_ (Office

CONTRACTOR ADDRESS R.R. 3 \_\_\_\_\_ Use Only)

Iola, Kansas 66749 KCC \_\_\_\_\_

TOTAL DEPTH 1501 PBTD \_\_\_\_\_ KGS

SPUD DATE 11-7-83 DATE COMPLETED 11-15-83 SWD/REP \_\_\_\_\_

ELEV: GR \_\_\_\_\_ DF \_\_\_\_\_ KB \_\_\_\_\_ PLG. \_\_\_\_\_

DRILLED WITH (CABLE) (ROTARY) (ATR) TOOLS. NGPA \_\_\_\_\_

DOCKET NO. OF DISPOSAL OR REPRESSURING WELL BEING USED TO DISPOSE OF WATER FROM THIS LEASE \_\_\_\_\_

Amount of surface pipe set and cemented 191' DV Tool Used? \_\_\_\_\_


TYPE OF COMPLETION THIS AFFIDAVIT APPLIES TO: (Circle ONE) - Oil, Shut-in Gas, Gas, Dry Disposal, Injection, Temporarily Abandoned. If OWWO, indicate type of re-completion \_\_\_\_\_. Other completion \_\_\_\_\_. NGPA filing \_\_\_\_\_.

ALL REQUIREMENTS OF THE STATUTES, RULES AND REGULATIONS PROMULGATED TO REGULATE THE OIL AND GAS INDUSTRY HAVE BEEN FULLY COMPLIED WITH.

A F F I D A V I T

\_\_\_\_\_, being of lawful age, hereby certifies that:

I am the Affiant, and I am familiar with the contents of the foregoing Affidavit.

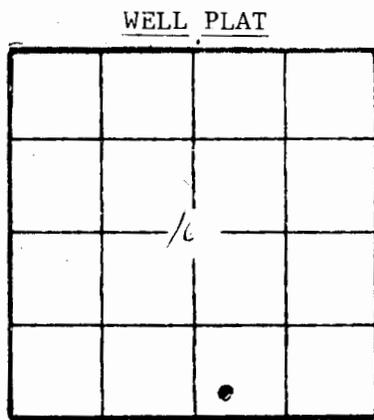

(Office Use Only) KCC \_\_\_\_\_ KGS  SWD/REP \_\_\_\_\_ PLG. \_\_\_\_\_ NGPA \_\_\_\_\_

38-91-0

Side TWO  
 OPERATOR Alco Drilling Co., Inc. LEASE NAME Rubick SEC 16 TWP 18 RGE 18 (E)  
 WELL NO 1 (W)

FILL IN WELL INFORMATION AS REQUIRED;

Show all important zones of porosity and contents thereof; cored intervals, and all drill-stem tests, including depth interval tested, cushion used, time tool open, flowing and shut-in pressures, and recoveries.

Show Geological markers, logs run, or other Descriptive information.

Formation description, contents, etc.	Top	Bottom	Name	Depth
Check if no Drill Stem Tests Run.				
Check if samples sent Geological Survey.				
Soil & clay	0	3 1/2		
Lime w/clay streaks	3 1/2	8		
Lime hard	8	14		
Shale	14	17		
Lime	17	18		
Shale	18	25		
White shale w/lime streaks	25	37		
Lime	37	43		
Shale w/sandy shale	43	190		
Lime	190	194		
Shale	194	336		
Lime	336	340		
Sand grey	340	352		
Lime w/shale	352	384		
Shale w/lime	384	402		
Lime	402	470		
Shale w/sandy shale	470	547		
Lime	547	579		
Shale	579	592		
Lime	592	597		
Shale w/lime	597	630		
Lime	630	651		
Shale	651	658		
Lime w/shale	658	736		
Shale	736	893		
Lime w/shale breaks	893	938		
Shale w/lime streaks	938	995		
Lime	995	1002		
Shale	1002	1280		

If additional space is needed use Page 2

Report of all strings set — surface, intermediate, production, etc. CASING RECORD (New) or (Used)

Purpose of string	Size hole drilled	Size casing set (in O.D.)	Weight lbs/ft.	Setting depth	Type cement	Sacks	Type and percent additives
Surface	9 7/8	7"	20	191	common	52	4% calcium

LINER RECORD			PERFORATION RECORD		
Top, ft.	Bottom, ft.	Sacks cement	Shots per ft.	Size & type	Depth interval

TUBING RECORD		
Size	Setting depth	Packer set at