

State Kansas County Marion

Company Messman-Rinehart Oil Co. Well No. 1

Farm Kroupa (Washdown)


Survey \_\_\_\_\_

Block No. \_\_\_\_\_ Sec. 18 Twp. 18 S Range 5 E

Co-Ord. \_\_\_\_\_ Elev. \_\_\_\_\_

SE NW NE

M-R Rig

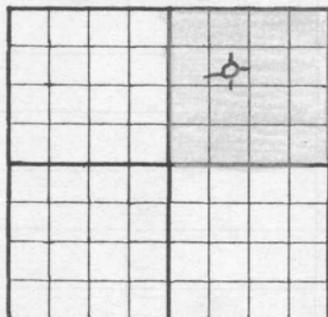

12.5%-A.A.Seeligson, Sr.  
25% -A.A.Seeligson, Jr.  
12.5%-Ralph Friedman  
25% -Chicago Group  
25% -M-R Oil Co.

2300' Dg. Sand test  
washdown of Robt. White  
#1 Christiansen

NOTE: Show Sketch of Lease and Well Location in Above Space

Ft. from N. Line

Ft. from S. Line

Ft. from W. Line

Ft. from E. Line

| Date    | Depth |  |
|---------|-------|--|
| 9/13/62 |       | M.I.R.T.                               |
| 9/14    |       | CO to T.D.                             |
|         |       | Ran Welex Log (encountered<br>no sand) |
| 9/16    |       | Dry and Abandoned<br>9/16/62           |
|         |       |  |
|         |       |  |
|         |       |  |