


Section 19 Township 18 Range 4E

Well No. #1 Sutik

Company W. R. Wilson et al

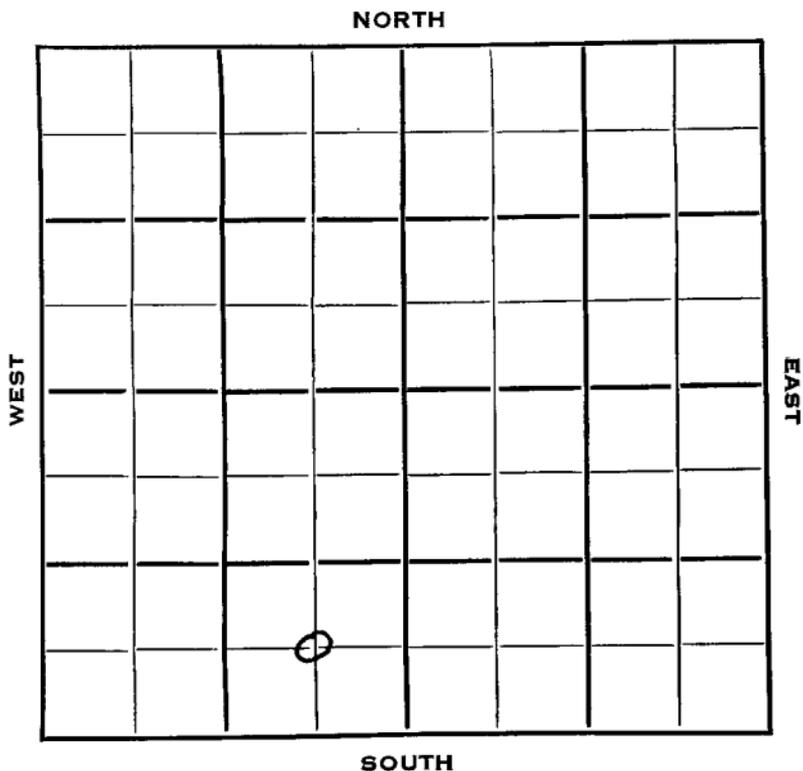

Marion

KANSAS

Sec. 19 Twp. 18 R. 4E

Well No. #1 Sutik Farm

W. R. Wilson et al Company

Sunflower Drlg. Contractor


Ft. from N. Line

660 Ft. from S. Line

660 Ft. from E. Line

Ft. from W. Line

C SE SW

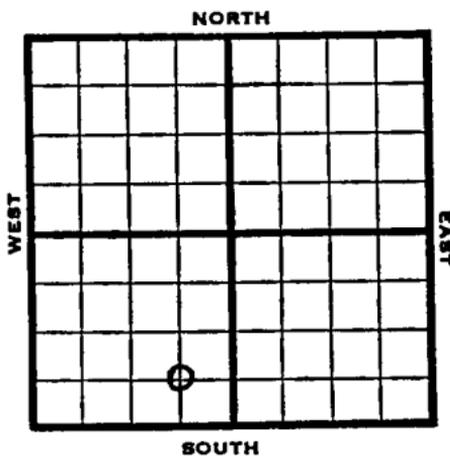

1953 Elev. 1425' REPORT

7/29 Spud 7-19-53  
 8" @ 90  
~~Drlg. 1676~~  
 Doug 1676  
 Drlg. 2746'

8/5 Spud 7-19-53  
 D & A  
 TD 3012'  
 8" @ 90'  
 Lans 1854, KC 2032, Miss 2440, Miss  
 Lime 2483, Kh. 2542, Hunton 2681, Syl-  
 van 2746, Viola 2838, Simp 2930, Arb  
 3001  
 TD 3012'  
 D & A

ABANDONED

2681  
 2440  
 ---  
 141

County Marion State Kansas

Sec. 19 (Blk. Twp.) 18 (Sur. Rge.) 4E Map No.

Operator W. R. Wilson et al.

Well No. 1 Farm Sutik

Elev. \_\_\_\_\_ Location C SE SW


FIRST REPORT

660 Ft. From S Line SW

660 Ft. From E Line Quarter

1st. Report JUL 29 1953

Completion \_\_\_\_\_

Remarks \_\_\_\_\_

Sunflower Drlg. - Contr

Spudding Date 7-19-53

Drig. Data

8" @ 90 Doug. 1676 drlg. 2746

J. G. MCGEHEE

County Marion State Kansas

Sec. 19 (Blk. 18 (Sur. 4E (Twp. 18 (Rge. 4E Map No.

Operator W. R. Wilson etal.

Well No. 1 Farm Sutik

Elev. 1425 Location C SE SW



660 Ft. From S Line SW

660 Ft. From E Line Quarter

1st. Report

Completion 4UG 5 1953

Remarks

Sunflower Drlg. - Contr.

Spudding Date 7-19-53

Drlg. Data D & A TD 3012

8" @ 90 Lans. 1854 KC 2032

Miss. 2440 Miss. lime 2483 Kh. 2542

Hunton 2681 Sylvian 2746 Viola 2838

Simp. 2930 Arb. 3001 TD 3012

D & A

**J. G. McGENEE**