


Lyon.

Map No. *X* Sec. *21* Twp. *18* R. *13*

Well No. *1 - Fuller* Farm

Watchman O. G. Company

NORTH

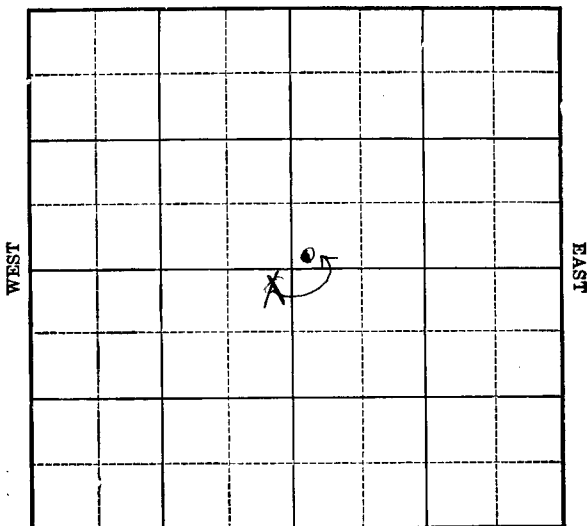

SOUTH

Location _____

Drilling Remarks

Rig Up _____

Drilling Remarks

RECORD

Cased _____ in. _____ ft.

Sand _____

Gas _____

Oil _____

Total Depth _____

PRODUCTION


1st 24 hrs. Nat. _____

1st 24 hrs. after shot _____

Gas _____ cu. ft.

Dry Hole _____

Abandoned _____

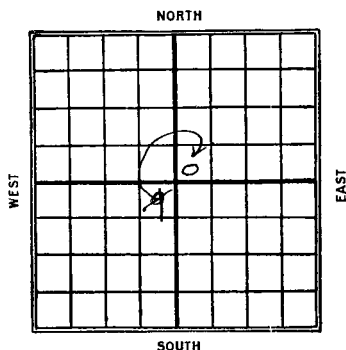Map No. Kansas Sec. 21 Twp. 18 R. 13Well No. 1- Fuller FarmWatchorn Oil Company~~330~~ Ft. from N. Line330 Ft. from S. Line~~330~~ Ft. from E. Line330 Ft. from W. Line

1926.

Date

REPORT

4/21 Location

4/28 Log

5/8 Rig

5/14 Drlg 325' Change location.

5/19 " 970

6/2 Drlg 1930' mixed sand.

6/10 " 2000

6/18 " 2330

6/24 S. & Q. 2500

Map No. **KANSAS** Sec. **21** Twp. **18** R. **13**
Well No. **1** **Fuller**
Watchman, Oil Co. Company

Contractor

FIRST REPORTS

SECTION PLAT

330 Ft. from N. Line
Ft. from S. Line
330 Ft. from E. Line
Ft. from W. Line

	o		

Location ☒
Rig up
Drilling and Remarks:

RECORD

Cased _____ in., _____ ft.
Sand _____
Gas _____
Oil _____
Total Depth _____

PRODUCTION

1st 24 hrs. Nat. _____
1st 24 hrs. after shot _____
Gas _____ Cu. Ft.
Dry Hole _____
Abandoned _____

Date
APR 21 1926 **CHAS. L. SHERWOOD**
192 _____ Scout

Map No. **KANSAS** Sec. **21** Twp. **18** R. **13**

Well No. **1** **Fulbr**

Notchory Oil Co. Company

Contractor

SECTION PLAT

Ft. from N. Line


330

Ft. from S. Line

Ft. from E. Line

330

Ft. from W. Line

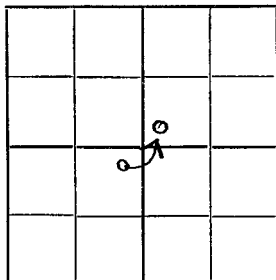

CORRECTION

Location

Rig up

Drilling and Remarks:

ok 325

chq location

RECORD

Cased _____ in., _____ ft.

Sand _____

Gas _____

Oil _____

Total Depth _____

PRODUCTION

1st 24 hrs. Nat. _____

1st 24 hrs. after shot _____

Gas _____ Cu. Ft.

Dry Hole _____

Abandoned _____

Date

MAY 12 1926

CHAS. L. SHERWOOD

192

Scout

Map No. KANSAS Sec. 21 Twp. 18 R. 13
 Well No. Fuller
Watchorn Oil & C. Company

Contractor

COMPLETED

SECTION PLAT

		o	

Ft. from N. Line

330

Ft. from S. Line

Ft. from E. Line

330

Ft. from W. Line

ABANDONED

Location

Rig up

Drilling and Remarks:

Top line 1950

Wilcox 2493-2500

DFH.

O.G. 2500

RECORD

Cased _____ in., _____ ft.

Sand _____

Gas _____

Oil _____

Total Depth 2500'

PRODUCTION

1st 24 hrs. Nat. _____

1st 24 hrs. after shot _____

Gas _____ Cu. Ft.

Dry Hole ☒Abandoned ☒

Date

JUN 24 1926

CHAS. L. SHERWOOD

192

Scout