


KANSAS
 Map No. _____ Sec. 21 Twp. 18 R. 4
 Well No. 1-Frontage Farm _____
Yunker et al Company _____

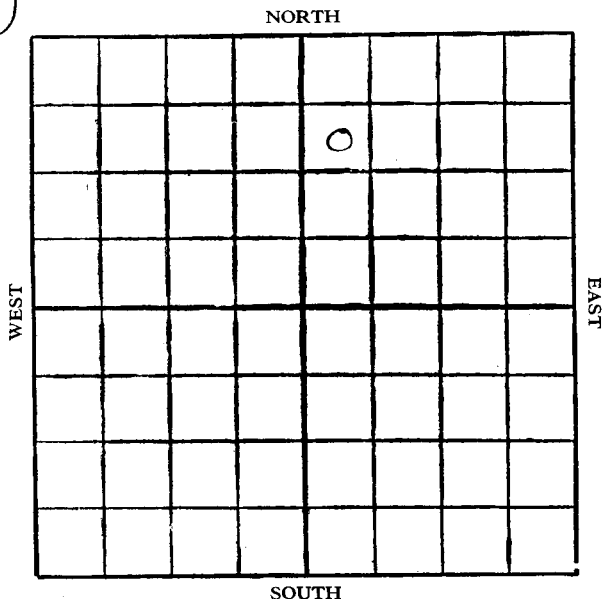

Location _____
 Drilling Remarks _____

Rig Up _____
 Drilling Remarks _____

RECORD

Cased _____ in. _____ ft.
 Sand _____
 Gas _____
 Oil _____
 Total Depth _____

PRODUCTION

1st 24 hrs. Nat. _____
 1st 24 hrs. after shot _____
 Gas _____ cu. ft.
 Dry Hole _____
 Abandoned _____


Map No. KANSAS Sec. 21 Twp. 18 R. 4
 Well No. 1-Fronta Farm
Youker et al Company

990 Ft. from N. Line

_____ Ft. from S. Line

_____ Ft. from E. Line

330 Ft. from W. Line

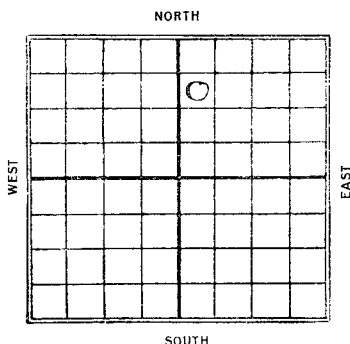

1928

Date	REPORT
<u>5/31</u>	<u>Rig up</u>
<u>6/7</u>	<u>Rig</u>
<u>6/14</u>	<u>—</u>
<u>6/21</u>	<u>—</u>
<u>6/28</u>	<u>Spudded + S.D.</u>
<u>7/6</u>	<u>—</u>
<u>7/13</u>	<u>—</u>
<u>7/19</u>	<u>—</u>
<u>7/26</u>	<u>Rig up.</u>
<u>8/2</u>	<u>Drilling 425</u>
<u>8/9</u>	<u>" 840</u>
<u>8/16</u>	<u>—</u>
<u>8/23</u>	<u>SD - 1840</u>
<u>8/28</u>	<u>—</u>
<u>9/4</u>	<u>Wrlg 1950'</u>
<u>9/12</u>	<u>" 2255</u>
<u>9/19</u>	<u>Chat 2395-2427</u>
	<u>HFW 8/D</u>
<u>9/26</u>	<u>—</u>
<u>10/3</u>	<u>Chat 2395-2427'</u>
	<u>HFW.</u>
	<u>T.D. 2427 WYA</u>

Marion
~~no tracing~~
KANSAS *21* SEC. *18* TWP. *4* R.
 MAP NO. *1* *Fronta*
 WELL NO. *Yunker et al* COMPANY
 CONTRACTOR

FIRST REPORTS

990 FT. FROM N. LINE
 FT. FROM S. LINE
 FT. FROM E. LINE
330 FT. FROM W. LINE

SECTION PLAT

		0	

LOCATION ☒RIG UP ☒

DRILLING AND REMARKS:

RECORD

CASED _____ IN. _____ FT.

SAND _____

GAS _____

OIL _____

TOTAL DEPTH _____

PRODUCTION

1ST 24 HRS. NAT. _____

1ST 24 HRS. AFTER SHOT _____

GAS _____ CU. FT.

DRY HOLE _____

ABANDONED _____

DATE

MAY 31 1928

CHAS. L. SHERWOC

192

SCOUT

Marion

KANSAS
 MAP No. 1 SEC. 21 TWP. 18 R. 4
 Well No. Fronta

Yowler et al

COMPANY

CONTRACTOR

SECTION PLAT

COMPLETED

990

FT. FROM N. LINE

FT. FROM S. LINE

FT. FROM E. LINE

330

FT. FROM W. LINE

ABANDONED

		0	

LOCATION _____

RIG UP _____

DRILLING AND REMARKS:

Chat 2395- 2427
 4FW.

RECORD

CASED _____ IN., _____ FT.

SAND _____

GAS _____

OIL _____

TOTAL DEPTH 2427

PRODUCTION

1ST 24 HRS. NAT. _____

1ST 24 HRS. AFTER SHOT _____

GAS _____ CU. FT.

DRY HOLE ☒ABANDONED ☒

DATE

OCT 3 1928

CHAS. L. SHERWOOD

SCOUT