

KANSAS


FORM 51 25M 3-49 PETROL

Lyon ✓

Section 22 Township 18 Range 10-E

Well No. #1 Grinnet

Company Ray Anderson etal

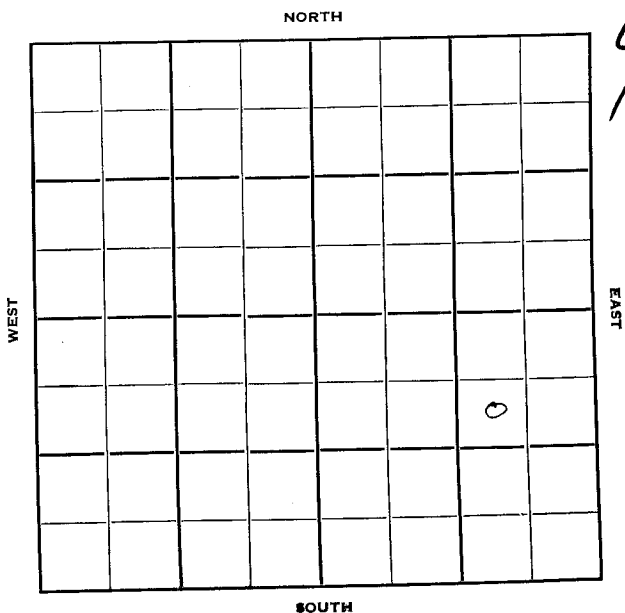

Lyon  
18

KANSAS

Sec. 22 Twp. R. 10E ✓

Well No. #1 Grinnet Farm

Ray Anderson et al Company

Contractor

Wildcat


990' Ft. from N. Line

Ft. from S. Line

990' Ft. from E. Line

Ft. from W. Line

SW NE SE

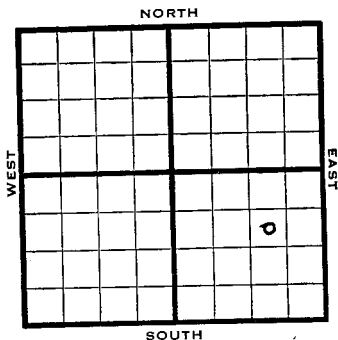

1950

Elev 1231 REPORT

8/9

Spud 8-7-50  
8" @ 100'  
Drlg. 460


8/23

TD 1652  
8" @ 100  
Heeb 970  
KC 1379  
TD 1652  
D&A

Lans 1265

ABANDONED

County Lyon State Kansas  
 Sec. 22 (<sup>Blk.</sup>18) (<sup>Sur.</sup>10E) Map No. \_\_\_\_\_  
 Operator Ray Anderson et al.  
 Well No. 1 Farm Grinnet  
 Elev. \_\_\_\_\_ Location SW NE SE

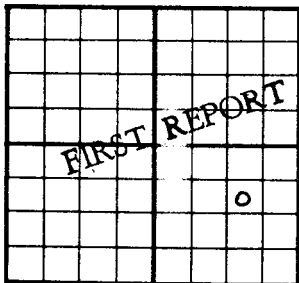


990 Ft. From N Line SE  
990 Ft. From E Line Quarter  
 1st. Report AUG 9 1950  
 Completion \_\_\_\_\_  
 Remarks \_\_\_\_\_  
 Spudding Date 8-7-50

Drlg. Data Wildcat

8" @ 100 drlg. 460

J. E. TYRA

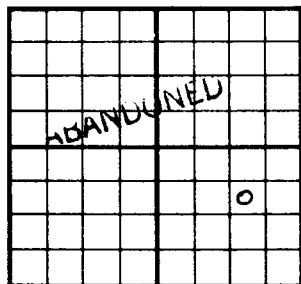County Lyon State KansasSec. 22 (Blk.  
Twp.) 18 (Sur.  
Rge.) 10E Map No.Operator Ray Anderson et al.Well No. 1 Farm GrinnetElev. 1231 Location SW NE SE990 Ft. From N Line SE990 Ft. From E Line Quarter

1st. Report

Completion AUG 23 1950

Remarks

WildcatSpudding Date 8-7-50Drig. Data D & A TD 16528" @ 100 Heeb. 970 Lans. 1265 KC 1379TD 1652 D & A

J. E. TYRA