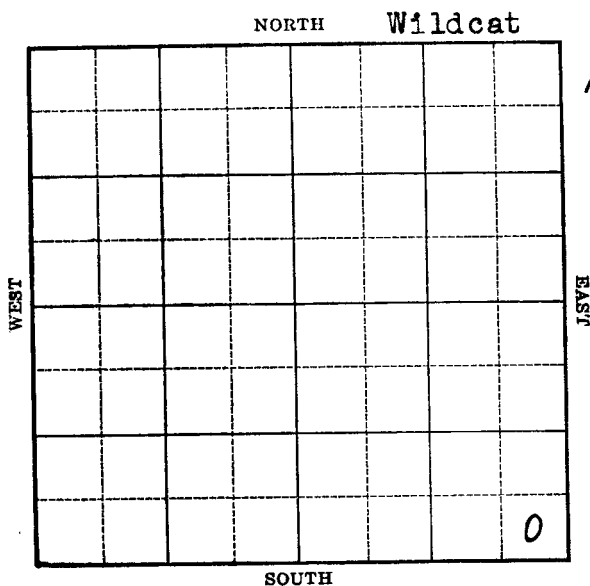


Marion

KANSAS


Section 23 Township 18 Range 5-EWell No. #1 C. K. JunghannsCompany Tidewater et al

KANSAS

Marion

Sec. 23 Twp. 18 R. 5-EWell No. #1 C. K. Junghanns FarmTidewater et al Company

Wildcat)

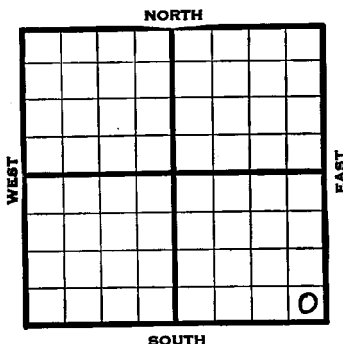 Ft. from N. Line330 Ft. from S. Line330 Ft. from E. Line Ft. from W. Line

Elev. 1452

	REPORT
1939	
5/24	Machine.
6/1	Spud 350'
6/8	12" @ 405'
	10" @ 1010'
	Topeka 1029'
	Drlg. 1280'
6/16	8" - 1590' trans. 1576'
	Drlg. 1845'
6/23	Drlg. 1995'
6/29	6" - 2120' Viola 2110'
	Simp. 2146' Simp. sand 2150'
	T.D. 2164' H.F.W. Shut down.
7/5	Arb. 2226'
	T.D. 2303'
	No shows.
	ABANDONED

Marion

KANSAS

Map No. 26 Sec. 23 Twp. 18 R. 5EWell No. 1 C. K. JunghannsTidewater etal Company

Contractor

FIRST REPORT

SE/C

SECTION PLAT

			o

 Ft. from N. Line330 Ft. from S. Line330 Ft. from E. Line Ft. from W. Line

WILDCAT

Location Rig up

Drilling and Remarks:

Mach.

RECORD

Cased in., ft.Sand Gas Oil Total Depth

PRODUCTION

1st 24 hrs. Nat. 1st 24 hrs. after shot Gas Cu. Ft.Dry Hole Abandoned

Date

MAY 24 1939 ₁₉

S. J. LEWIS Scout

KANSAS

Marion

Map No. 26 Sec. 23 Twp. 18 R. 5EWell No. 1 C. K. Junghanns

Tidewater etal

Company

Contractor

ABANDONED

SE/C

____ Ft. from N. Line

330 Ft. from S. Line330 Ft. from E. Line

____ Ft. from W. Line

SECTION PLAT

			o

WILDCAT

Location _____

Rig up _____

Drilling and Remarks:

*cut 2226.**No shows.*

RECORD

Cased _____ in., _____ ft.

Sand _____

Gas _____

Oil _____

Total Depth 2303

PRODUCTION

1st 24 hrs. Nat. _____

1st 24 hrs. after shot _____

Gas _____ Cu. Ft.

Dry Hole _____

Abandoned _____

Date

JUL 5 1939 19

S. J. LEWIS Scout