


Map No. Kansas Sec. 23 Twp. 18 R. 10 ✓

Well No. 1 Ball Farm

O. J. Connell Company

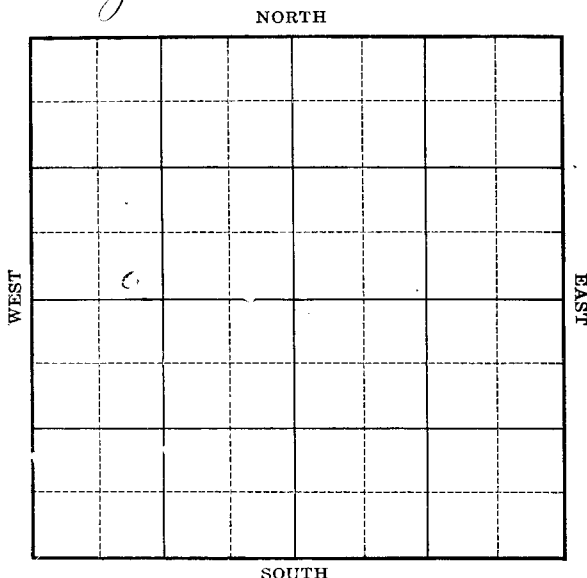

Location _____

Drilling Remarks

Rig Up _____

Drilling Remarks

RECORD

Cased _____ in. _____ ft.

Sand _____

Gas _____

Oil _____

Total Depth _____

PRODUCTION

1st 24 hrs. Nat. _____

1st 24 hrs. after shot _____

Gas _____ cu. ft.

Dry Hole _____

Abandoned _____


Lyon Co

Map No. Kansas Sec. 23 Twp. 18 R. 10Well No. 1 Ball FarmO. J. Connell Company

Ft. from N. Line

200 Ft. from S. Line

Ft. from E. Line

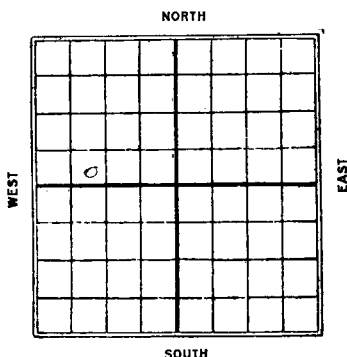1120 Ft. from W. Line

Date	REPORT
<u>1/20</u>	<u>Location</u>
<u>2/7</u>	<u>—————</u>
<u>2/4</u>	<u>—————</u>
<u>2/10</u>	<u>—————</u>
<u>2/17</u>	<u>—————</u>
<u>2/24</u>	<u>—————</u>
<u>3/5</u>	<u>—————</u>
<u>3/10</u>	<u>—————</u>
<u>3/18</u>	<u>Dlg 300'</u>
<u>3/25</u>	<u>" 840</u>
<u>3/31</u>	<u>" 1000'</u>
<u>4/7</u>	<u>" 1220</u>
<u>4/14</u>	<u>" 1425</u>
<u>4/21</u>	<u>Good show oil in</u> <u>Osage line 1618-1620,</u> <u>dlg 2035.</u>
<u>4/28</u>	<u>Running 8" 2200'</u>
<u>5/8</u>	<u>Isq at 2200</u>
<u>5/14</u>	<u>Dlg 2250'</u>
<u>5/12</u>	<u>I.D. 2360' Good show</u> <u>oil in Osage line</u> <u>1618' Top line 2307</u> <u>1618 2360' Hw</u>

Map No. *no map* **KANSAS** Sec. *23* Twp. *18* R. *10*

Well No. *1* *o J* *Connell* *Inc* Company

Contractor

COMPLETED

SECTION PLAT

_____ Ft. from N. Line

200 _____ Ft. from S. Line

_____ Ft. from E. Line

1120 _____ Ft. from W. Line

ABANDONED

Location _____

Rig up _____

Drilling and Remarks:

Good show oil in
Osageo lime 1618
top lime 2307

129

2360 AFH

RECORD

Cased _____ in., _____ ft.

Sand _____

Gas _____

Oil _____

Total Depth *2360*

PRODUCTION

1st 24 hrs. Nat. _____

1st 24 hrs. after shot _____

Gas _____ Cu. Ft.

Dry Hole ☒

Abandoned ☒

Date

MAY 19 1926

CHAS. L. SHERWOOD

192

Scout

Lyon Co

no map ^{map} KANSAS Sec. 23 Twp. 18 R. 10
 Map No. _____

Well No. 1 B444
 O. J. Connell _____ Company

 Contractor

FIRST REPORTS

_____ Ft. from N. Line

200 _____ Ft. from S. Line

_____ Ft. from E. Line

1120 _____ Ft. from W. Line

SECTION PLAT

o			

Location ☒ _____

Rig up _____

Drilling and Remarks:

RECORD

Cased _____ in., _____ ft.

Sand _____

Gas _____

Oil _____

Total Depth _____

PRODUCTION

1st 24 hrs. Nat. _____

1st 24 hrs. after shot _____

Gas _____ Cu. Ft.

Dry Hole _____

Abandoned _____

Date

JAN 20 1926 ¹⁹² CHAS. L. SHERWOOD
 _____ Scout