


Lyon ✓

Section 23 Township 18 Range 10E

Well No. 1 Ball

Company Huber et al

Wildcat  
NORTH

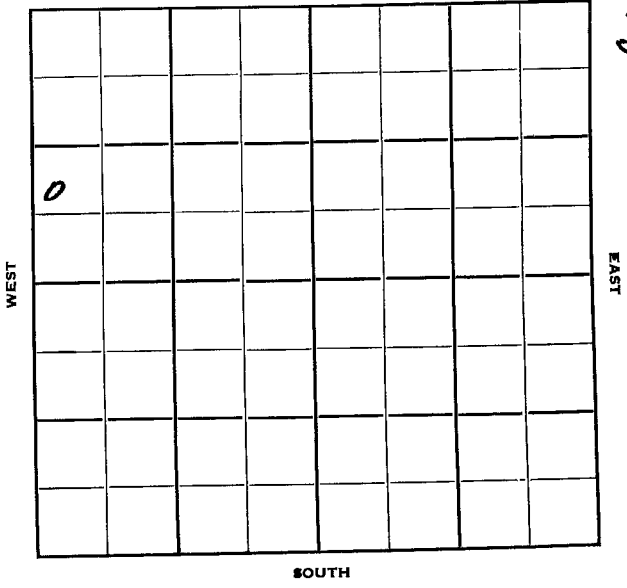

5

Lyon

KANSAS

Sec. 23 Twp. 18 R. 10E

Well No. #1 Ball Farm

Huber et al Company

Wildcat (Pabco, Cont.)

\_\_\_\_\_ Ft. from N. Line

990'


\_\_\_\_\_ Ft. from S. Line

\_\_\_\_\_ Ft. from E. Line

330'

\_\_\_\_\_ Ft. from W. Line

NW SW NW

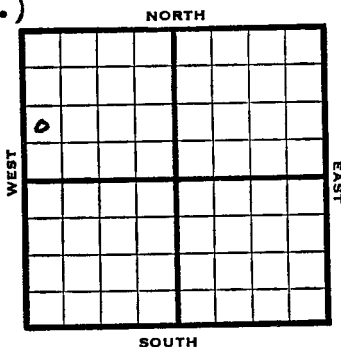

1949

Elev 1241'

REPORT

8/31

8" @ 196'

Lans. 1261'

Drlg. 1350'

9/7

Miss 2269'

Hunton 2765'

BKC 1650'

Drlg. 2861'

9/14

Viola 2640'

Simpson 2878'

Arb. 2943'-85'

TD 2985'

5" @ 1681'

9/21

"

9/28

"

10/5

"

10/12

TD 2985'

Arb. 2943'

Aband.

**ABANDONED**

2162  
2279  
676

Map No. \_\_\_\_\_ Sec. 23 Twp. 18 R. 10E

Well No. 1 Ball

Huber et al. \_\_\_\_\_ Company

Fabco \_\_\_\_\_ Contractor

FIRST REPORT  
SECTION PLAT

NE SW NW

6			

Ft. from N. Line

990 Ft. from S. Line

Ft. from E. Line

330 Ft. from W. Line

Lyön County

Location \_\_\_\_\_

Rig up \_\_\_\_\_

Drilling and Remarks:

8" 196

Lans. 1261

drle. 1350

RECORD

Cased \_\_\_\_\_ in., \_\_\_\_\_ ft.

Sand \_\_\_\_\_

Gas \_\_\_\_\_

Oil \_\_\_\_\_

Total Depth \_\_\_\_\_

PRODUCTION

1st 24 hrs. Nat. \_\_\_\_\_

1st 24 hrs. after shot \_\_\_\_\_

Gas \_\_\_\_\_ Cu. Ft.

Dry Hole \_\_\_\_\_

Abandoned \_\_\_\_\_

Date

AUG 31 1949

S. J. LEWIS Scout

Map No. \_\_\_\_\_ Sec. 23 Twp. 18 R. 10E

Well No. 1 Ball

Huber et al. Company

**ABANDONED** Contractor

NW SW NW

*E1,1241*  
SECTION PLAT

o			

\_\_\_\_\_ Ft. from N. Line

990 Ft. from S. Line

\_\_\_\_\_ Ft. from E. Line

330 Ft. from W. Line

Lyon County

Location \_\_\_\_\_

Rig up \_\_\_\_\_

Drilling and Remarks:

*Cor 2943*

**RECORD**

Cased \_\_\_\_\_ in., \_\_\_\_\_ ft.

Sand \_\_\_\_\_

Gas \_\_\_\_\_

Oil \_\_\_\_\_

Total Depth 2885

**PRODUCTION**

1st 24 hrs. Nat. \_\_\_\_\_

1st 24 hrs. after shot \_\_\_\_\_

Gas \_\_\_\_\_ Cu. Ft.

Dry Hole \_\_\_\_\_

Abandoned \_\_\_\_\_

Date

OCT 12 1949

19

S. J. LEWIS

Scout