


Map No. Kansas Sec. 25 Twp. 18 R. 6 ✓

Well No. X Lips Farm
Preston + Pasewalk Company

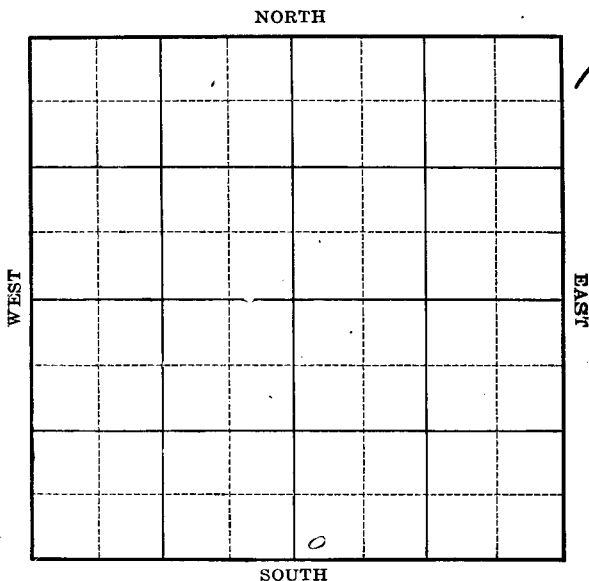

Location _____

Drilling Remarks _____

Rig Up _____

Drilling Remarks _____

RECORD

Cased _____ in. _____ ft.

Sand _____

Gas _____

Oil _____

Total Depth _____

PRODUCTION

1st 24 hrs. Nat. _____

1st 24 hrs. after shot _____

Gas _____ cu. ft.

Dry Hole _____

Abandoned _____


Chase Co

Map No. Kansas Sec. 25 Twp. 18 R 6Well No. X Lap FarmPreston + Pasewalk Company

Ft. from N. Line

200 Ft. from S. Line

Ft. from E. Line

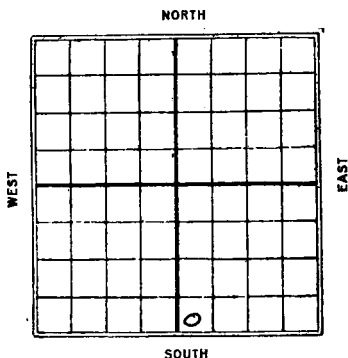200 Ft. from W. LineDate
1925

REPORT

8/19 Location9/2410/1 same10/810/1610/2210/2911/611/1311-1911-2712/312/1012/1712/2312/3119261/81/141/201/212/4

2/10 - _____

2/17 - _____

2/24 - _____

3/5 - _____

3/10 - _____

3/18 - _____

3/25 - _____

4/1 - Rig change well no.

4/7 - _____

4/15 - _____

4/21 - _____

4/28 - _____

5/8 - Same

5/14 Dlg 400'

5/19 " 843'

6/2 - Sand 1248-63' 4 1/2 M. gas
450 lb. R. P.

6/10 - _____

6/18 - _____

6/25 - _____

6-20 fishing tools 1680

7/15 - _____

7/22 - _____

7/28 - _____

8/4 - _____

8/11 - Dlg 1690

8/18 - _____

8/25 - Dlg 2005

9/1 - 4 m gas 1248-63
Granite 2025-2092
D. & A. 2092 - J. D.

Map No. KANSAS Sec. 25 Twp. 18 R. 6
 Well No. 1 Hips
Matton & Radewalk Company

Contractor

FIRST REPORTS

SECTION PLAT

_____ Ft. from N. Line

200 Ft. from S. Line

_____ Ft. from E. Line

200 Ft. from W. Line

		o	

Location ☒ _____

Rig up _____

Drilling and Remarks:

RECORD

Cased _____ in., _____ ft.

Sand _____

Gas _____

Oil _____

Total Depth _____

PRODUCTION

1st 24 hrs. Nat. _____

1st 24 hrs. after shot _____

Gas _____ Cu. Ft.

Dry Hole _____

Abandoned _____

Date

SEP 19 1925

192 CHAS. L. SHERWOOD

Scout

Norman KANSAS Sec. *25* Twp. *18* R. *6*
 Map No. _____
 Well No. *2* *hips*

Reston & Hadenwald Company

Contractor

SECTION PLAT

		0	

_____ Ft. from N. Line

200 _____ Ft. from S. Line

_____ Ft. from E. Line

200 _____ Ft. from W. Line

CORRECTION

Location *✓* _____

Rig up _____

Drilling and Remarks:

*Chg. steel pump
to above.*

*Change from
#1 to #2*

RECORD

Cased _____ in., _____ ft.

Sand _____

Gas _____

Oil _____

Total Depth _____

PRODUCTION

1st 24 hrs. Nat. _____

1st 24 hrs. after shot _____

Gas _____ Cu. Ft.

Dry Hole _____

Abandoned _____

Date

MAR 31 1926

CHAS. L. SHERWOOD

192

Scout

no ~~map~~ KANSAS *cho 2e*
 Map No. *25* Sec. *18* Twp. *6*

Well No. *2*
Alston & Padewsky

Company

Contractor

COMPLETED

SECTION PLAT

Ft. from N. Line

200

Ft. from S. Line

Ft. from E. Line

200

Ft. from W. Line

ABANDONED

		0	

Location

Rig up

Drilling and Remarks:

*LM 200 1248-63**Granite 2025-**2092'**DRG**2092'*

RECORD

Cased _____ in., _____ ft.

Sand _____

Gas _____

Oil _____

Total Depth *2092'*

PRODUCTION

1st 24 hrs. Nat. _____

1st 24 hrs. after shot _____

Gas _____ Cu. Ft.

Dry Hole ☒Abandoned ☒

Date

SEP 1 1926

CHAS. L. SHERWOOD

192

Scout